IT IS THE CONTRACTOR'S RESPONSIBILITY TO ENSURE THAT ALL CONSTRUCTION CONFORMS TO THE REQUIREMENTS OF THE ONTARIO BUILDING CODE. NOTATIONS MADE ON THESE DRAWINGS ARE FOR YOUR INFORMATION AND ASSISTANCE ONLY AND DO NOT NECESSARILY COMMENT ON ALL AREAS OF CONSTRUCTION

APPROVED DRAWINGS HAVE BEEN RED LINED INDICATING A CHANGE TO MEET THE OBC. PLEASE REVIEW ALL PAGES TO ENSURE YOU ARE PROPERLY INFORMED OF CHANGES.

CALL FOR INSPECTION OF EXCAVATION CRIBBING BEFORE POURING ANY CONCRETE

ANY MODIFICATIONS TO GRADING SHALL NOT ADVERSELY AFFECT **NEIGHBORING PROPERTIES**



FRONT ELEVATION 'A'

INSPECTIONS ARE REQUIRED TO BE EMAILED IN TO BUILDING@NORTHDUMFRIES.CA 24 HOURS IN ADVANCE OF THE REQUIRED INSPCTION.



FRONT ELEVATION 'B'

NEITHER THE GRANTING OF A PERMIT NOR THE APPROVAL OF SPECS & DRAWINGS NOR INSPECTIONS MADE BY THE OFFICIAL HAVING JURISDICTION SHALL RELIEVE THE OWNER FROM REQUIREMENTS OF THE ONTARIO BUILDING CODE AND ANY OTHER REFERENCED REQUIREMENTS.

Drawing List:

- A0 TITLE SHEET
- A1 BASEMENT FLOOR ELEV 'A'
- A2 GROUND FLOOR ELEV 'A'
- A3 SECOND FLOOR ELEV 'A'
- A4 BASEMENT FLOOR ELEV 'B'
- A5 GROUND FLOOR ELEV 'B'
- A6 SECOND FLOOR ELEV 'B'
- A7 ROOF PLAN ELEV 'A'
- FRONT ELEVATION 'A' **A8** RIGHT SIDE ELEVATION 'A'
- A9 REAR ELEVATION 'A' & 'B'
- LEFT SIDE ELEVATION 'A' A10
- FRONT ELEVATION 'B' A11
- ROOF PLAN ELEV 'B' A12 RIGHT SIDE ELEVATION 'B'
- A13 LEFT SIDE ELEVATION 'B' CONSTRUCTION NOTES D1
- CONSTRUCTION NOTES D2
- D3 CONSTRUCTION NOTES

Areas:

	ELEVATION 'A'		ELEVATION 'B'	
	SF	SM	SF	SM
GROUND FLOOR	1143.6	106.2	1143.6	106.2
SECOND FLOOR	1510.7	140.3	1515.5	140.8
TOTAL AREA	2654.3	246.6	2659.1	247.0
COVERAGE INC PORCH	1623.2	150.8	1592.3	147.9
COVERAGE NOT INC PORCH	1538.3	142.9	1538.3	142.9



TOWNSHIP OF NORTH DUMFRIES BUILDING DEPARTMENT

These Plans have been examined for Compliance with the Ontario Building Code requirements. A Building Permit has been Issued, subject to any changes noted, under the condition that the building will be constructed in accordance with the code

Adam Miller

12/20/2020

REVIEWED BY

DATE

Tice River Homes

Legacy







Ayr marketing name



40-03 project # 3/16" = 1'0" 17052

I, JORGE MORENO DECLARE THAT I HAVE REVIEWED AND TAKEN DESIGN RESPONSIBILITY FOR THE DESIGN WORK ON BEHALF OF RN DESIGN LTD. UNDER DIVISION C, PART-3 SUBSECTION-3.2.4 OF THE BUILDING CODE. I AM QUALIFIED AND THE FIRM IS REGISTERED IN THE APPROPRIATE CLASSES / CATEGORIES.

QUALIFIED DESIGNER BCIN: DATE:

SIGNATURE:

47245


project Legacy revisions date dwn chk # revisions date dwn chk ISSUED FOR CLIENT REVIEW 23-FEB-18 KK JM 5 RE-ISSUE FOR PERMIT 18-Oct-19 ES REVISED PER TRUSS COORDINATION 23-APR-18 LO JM REVISED PER ENGINEER COMMENTS & ISSUED FOR PERMIT MADE PARTIAL PLANS INTO FULL PLANS AS 20-JUL-18 WU JM 4-Oct-19 KC ES


THE FLOOR AND TRUSS LAYOUTS PROVIDED BY THE MANUFACTURER HAVE BEEN REVIEWED, APPROVED AND


COORDINATED ON THE WORKING DRAWING PLANS PROVIDED BY RN DESIGN

Tice River Homes

page

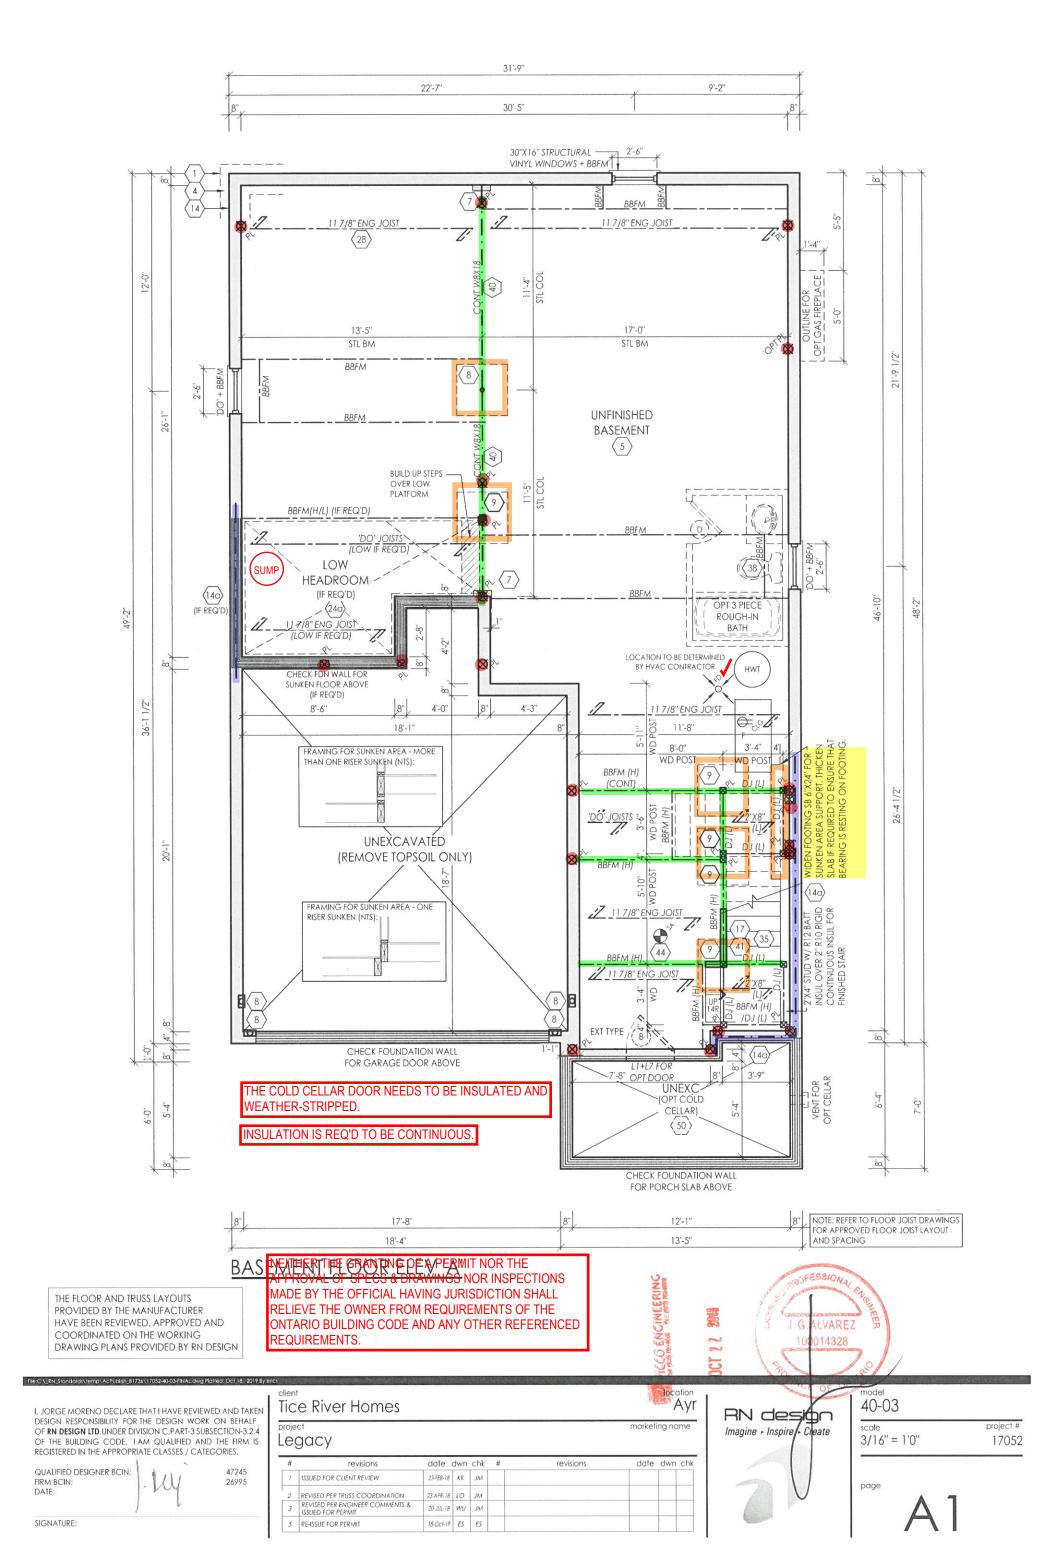

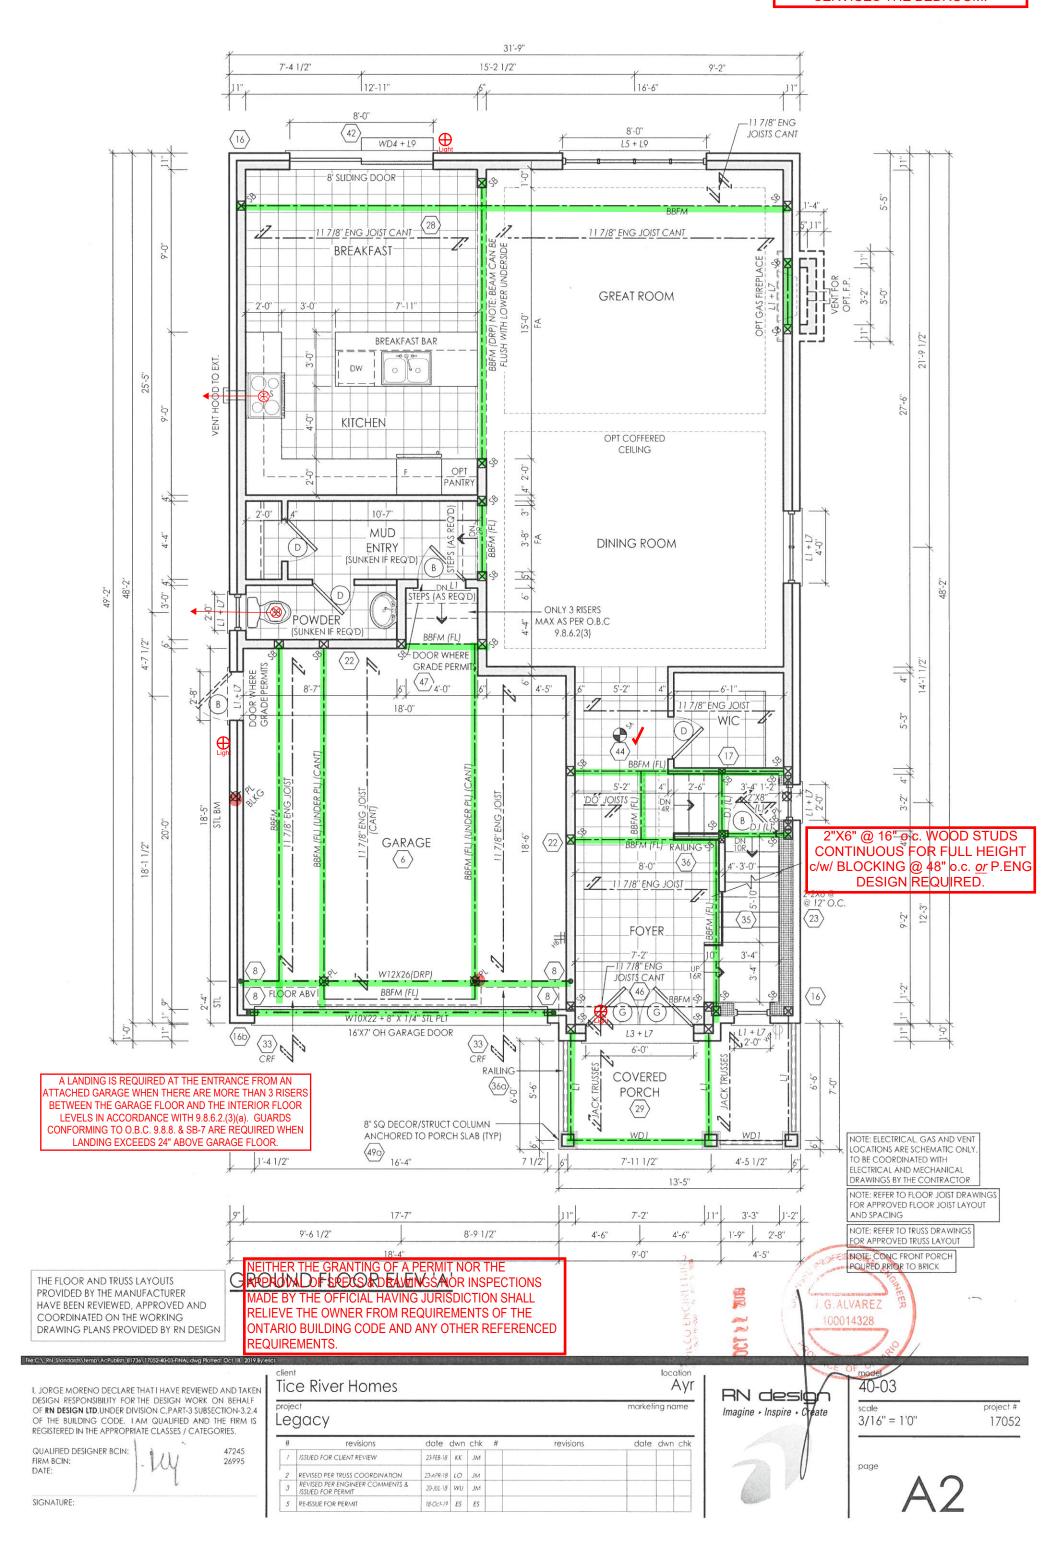

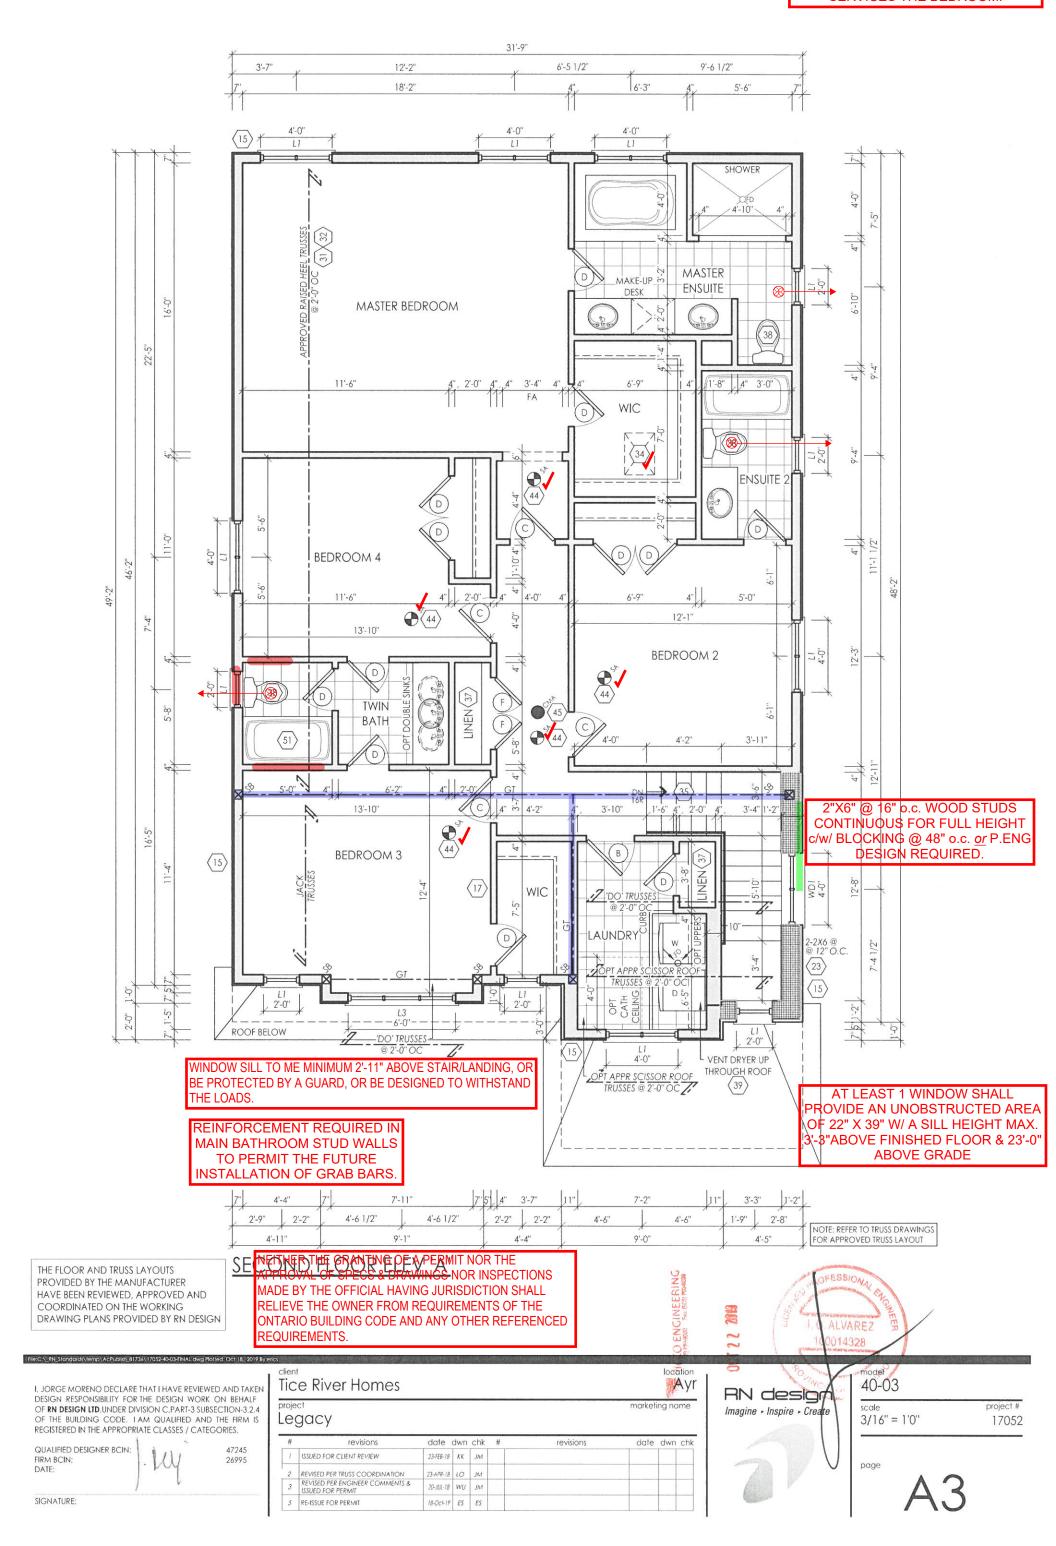


GROSS GLAZING AREA TOTAL PERIPHERAL WALL AREA 3284.59 SF 305.14 m² FRONT GLAZING AREA NEITHER THE GRANTING OF A PERMIT NOR THE 87.06 SF 8.09 m² LEFT SIDE GLAZING AREA 33.33 SF APPROVAL OF SPECS & DRAWINGS NOR INSPECTIONS 3.10 m² MADE BY THE OFFICIAL HAVING JURISDICTION SHALL RIGHT SIDE GLAZING AREA 77.66 SF 7.21 m² REAR GLAZING AREA 152.06 SF RELIEVE THE OWNER FROM REQUIREMENTS OF THE 14.13 m² ONTARIO BUILDING CODE AND ANY OTHER REFERENCED TOTAL GLAZING AREA 350.11 SF 32.53 m² 40-03 scale 3/16" = 1 REQUIREMENTS. 10.66 % TOTAL GLAZING PERCENTAGE NOTE: ALL CONVENTIONAL ROOF FRAMING TO CONFORM TO PART 9 OF THE OBC. ROOF RAFTERS THAT MEET OR CROSS OVER TRUSSES PEAK HEIGHT OF ROOF 30'-8" ARE TO BE 2"X4" SPF @ 24" O.C. WITH A 2"X4" SPF VERTICAL POST TO THE TRUSS UNDER, AT 6:12 EACH CROSS POINT, POSTS LONGER THAN 6' TO desig BE LATERALLY BRACED SO THAT THE DISTANCE BETWEEN END POINTS & BETWEEN ROWS OF BRACING DOES NOT EXCEED 6'. NOTE: REFER TO NOTE: REFER TO STREET-OC1 5 2 2019 TRUSS DRAWINGS SCAPES FOR POSSIBLE FOR APPROVED MINOR CHANGES DUE TO MID POINT OF ROOF 24'-5" TRUSS LAYOUT GRADING CONDITIONS PICCO ENCINEERINC SHINGLE SHAKE VINYL SIDING (TYP) ASPHALT SHINGLES -OPT CATHEDRAL CEILING BEYOND (7:12 SLOPE) W/ FLASHING AT VALLEYS (TYP) 2"+6" VINYL HEADER (31) BG. FOR STD CEILING-W/ CENTER KEYSTONE PRE-FINISHED ALUMINUM RWL AND -W/ 6" VINYL SURROUNDS GUTTER ON PRE-FINISHED FASCIA W/ 4" VINYL SILL (TYP) 12:12 12:12 BOARD AND VENTED SOFFIT (TYP) TOP OF PLATE 1"X6" DECOR ALUM FRIEZE BOARD (TYP) TOP OF TRANSOM 2"+6" VINYL HEADER -TOP OF WINDOW W/6" VINYL SURROUNDS VERTICAL BOARD & BATTEN VINYL SIDING (TYP) W/ 4" VINYL SILL (TYP) 6" VINYL CORNER TRIM (TYP) ROOF PLAN ELEV 'A' MTL FLASHING BEHIND (TYP) ES IM IM ES THE FLOOR AND TRUSS LAYOUTS 4:12 SECOND FLOOR PROVIDED BY THE MANUFACTURER KK KK WILD KK HAVE BEEN REVIEWED, APPROVED AND 8:12 U/S OF GARAGE COORDINATED ON THE WORKING & PORCH SOFFIT DRAWING PLANS PROVIDED BY RN DESIGN TOP OF WINDOW/TRANSOM 72X12 TOP OF DOOR . Homes ANCHORED TO PORCH SLAB (TYP) 8" SQ DECOR/STRUCT COLUMN BRICK SOLDIER COURSE HEADER W/ CENTER KEYSTONE (TYP) River -4" PRECAST CONC SILL (TYP) FACE BRICK (TYP) Legacy TOP OF BAND -36" HIGH PREFIN ALUM RAILING (TYP) (360) 4" PRECAST CONC BAND Tice W/ BRICK SOLDIER COURSE BAND GROUND FLOOR GROUND FLOOR 0'-0" FIN GRADE FIN GRADE 16'X7' OH GARAGE DOOR POURED CONC DOOR SILL POURED CONC PORCH SLAB (29) - 2-36"X82" EXT. DOORS (G) U/S OF FOOTING POURED CONC FDTN WALLS ON STEPPED FOOTING (TYP) CONC STRIP FOOTING (TYP) $\langle 1 \times 4 \times 14 \rangle$


FRONT ELEVATION 'A'

MORENO RESPONSIB ESIGN LTD.

TOP OF SLAB

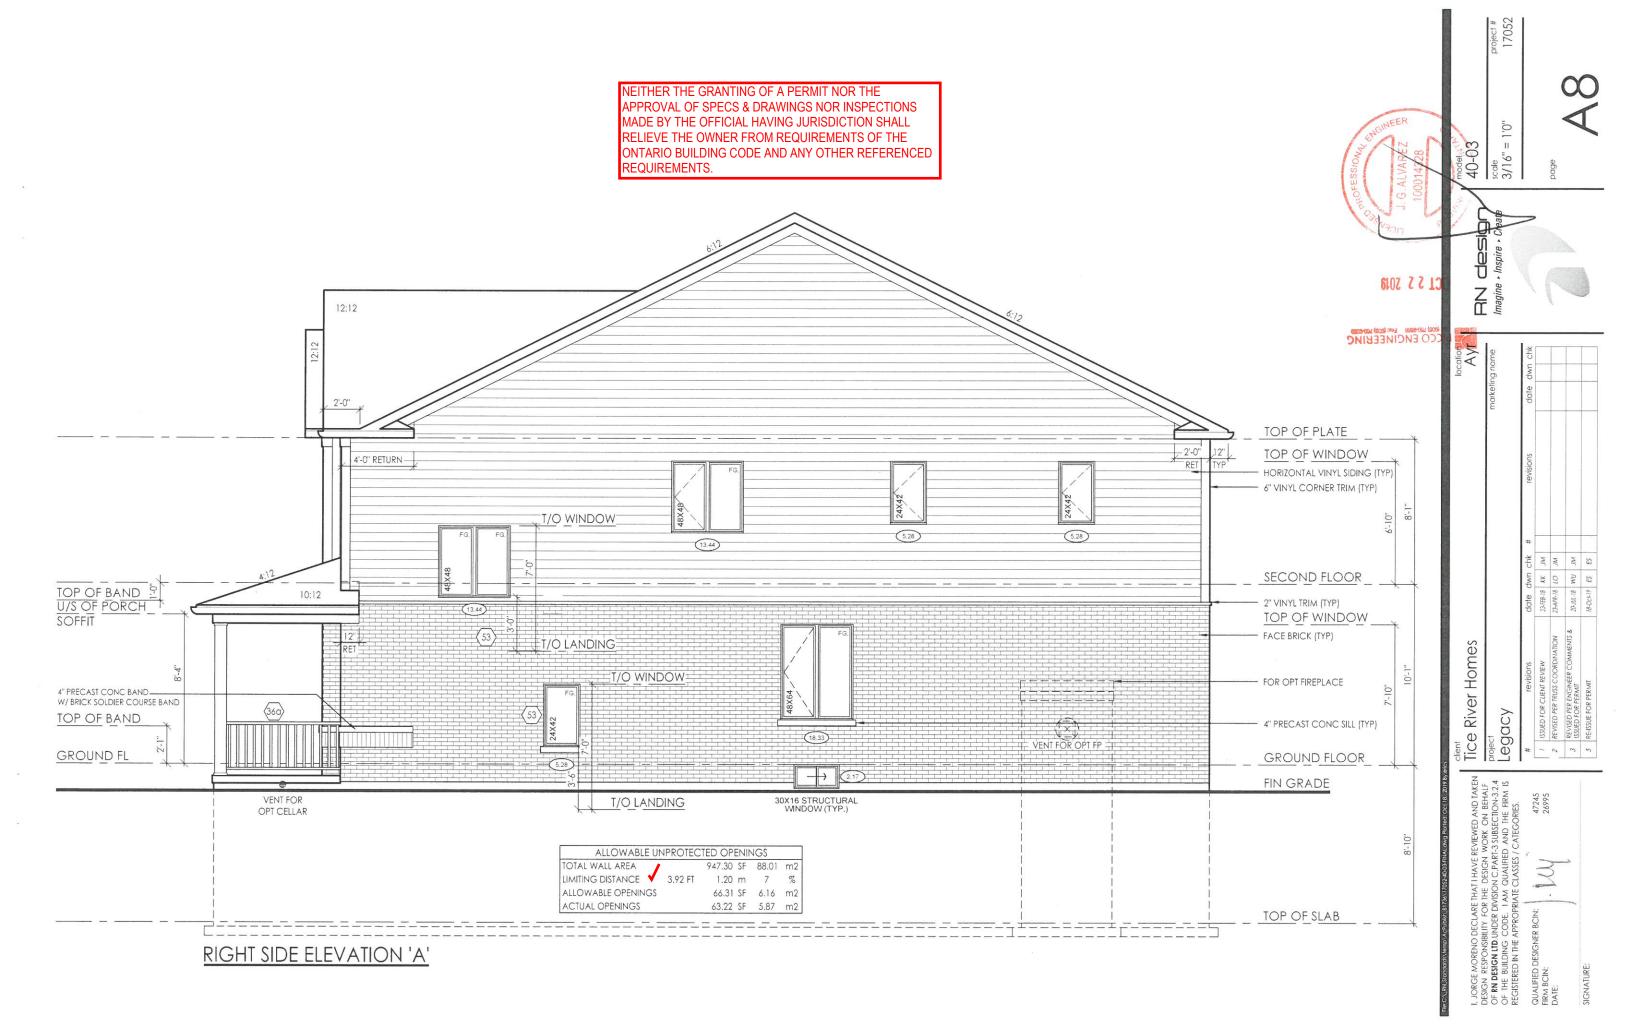

NEITHER THE GRANTING OF A PERMIT NOR THE APPROVAL OF SPECS & DRAWINGS NOR INSPECTIONS MADE BY THE OFFICIAL HAVING JURISDICTION SHALL RELIEVE THE OWNER FROM REQUIREMENTS OF THE ONTARIO BUILDING CODE AND ANY OTHER REFERENCED REQUIREMENTS.

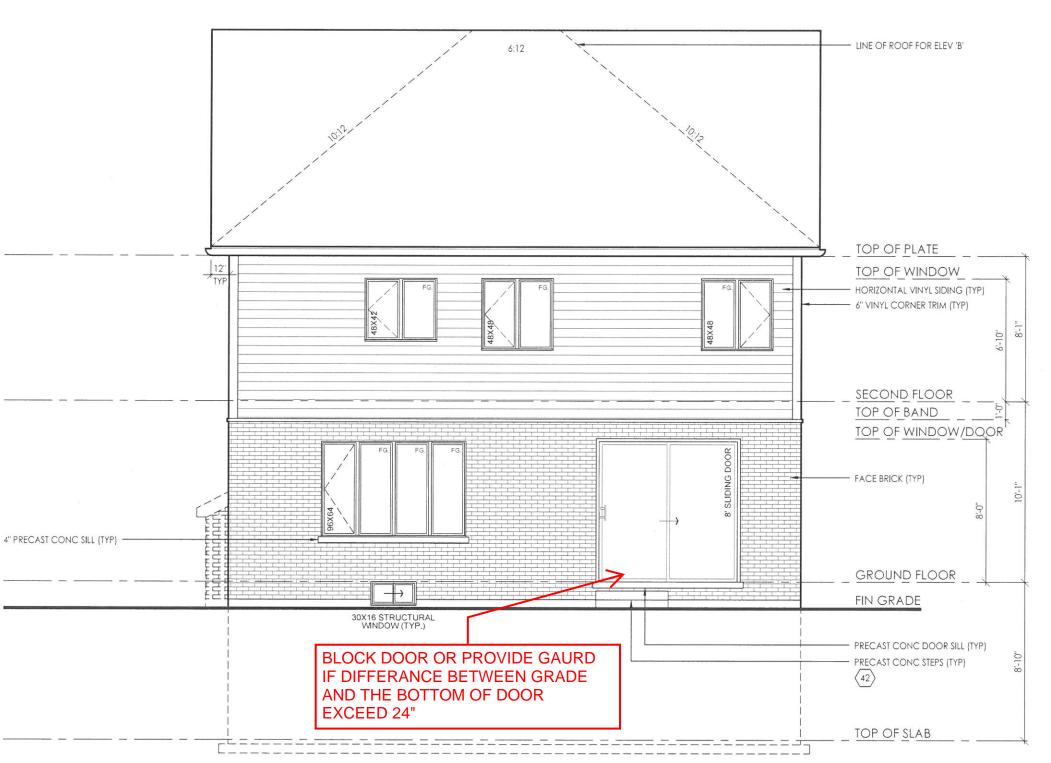

Ayr PICCO ENCINEERING Tice River Homes


project
Legacy

> I, JORGE MORENO D DESIGN RESPONSIBIL OF **RN DESIGN LTD**,UI OF THE BUILDING C REGISTERED IN THE AI

OCT 2 2 2019

40-03 scale 3/16" = 1'0"

REAR ELEVATION 'A' & 'B'

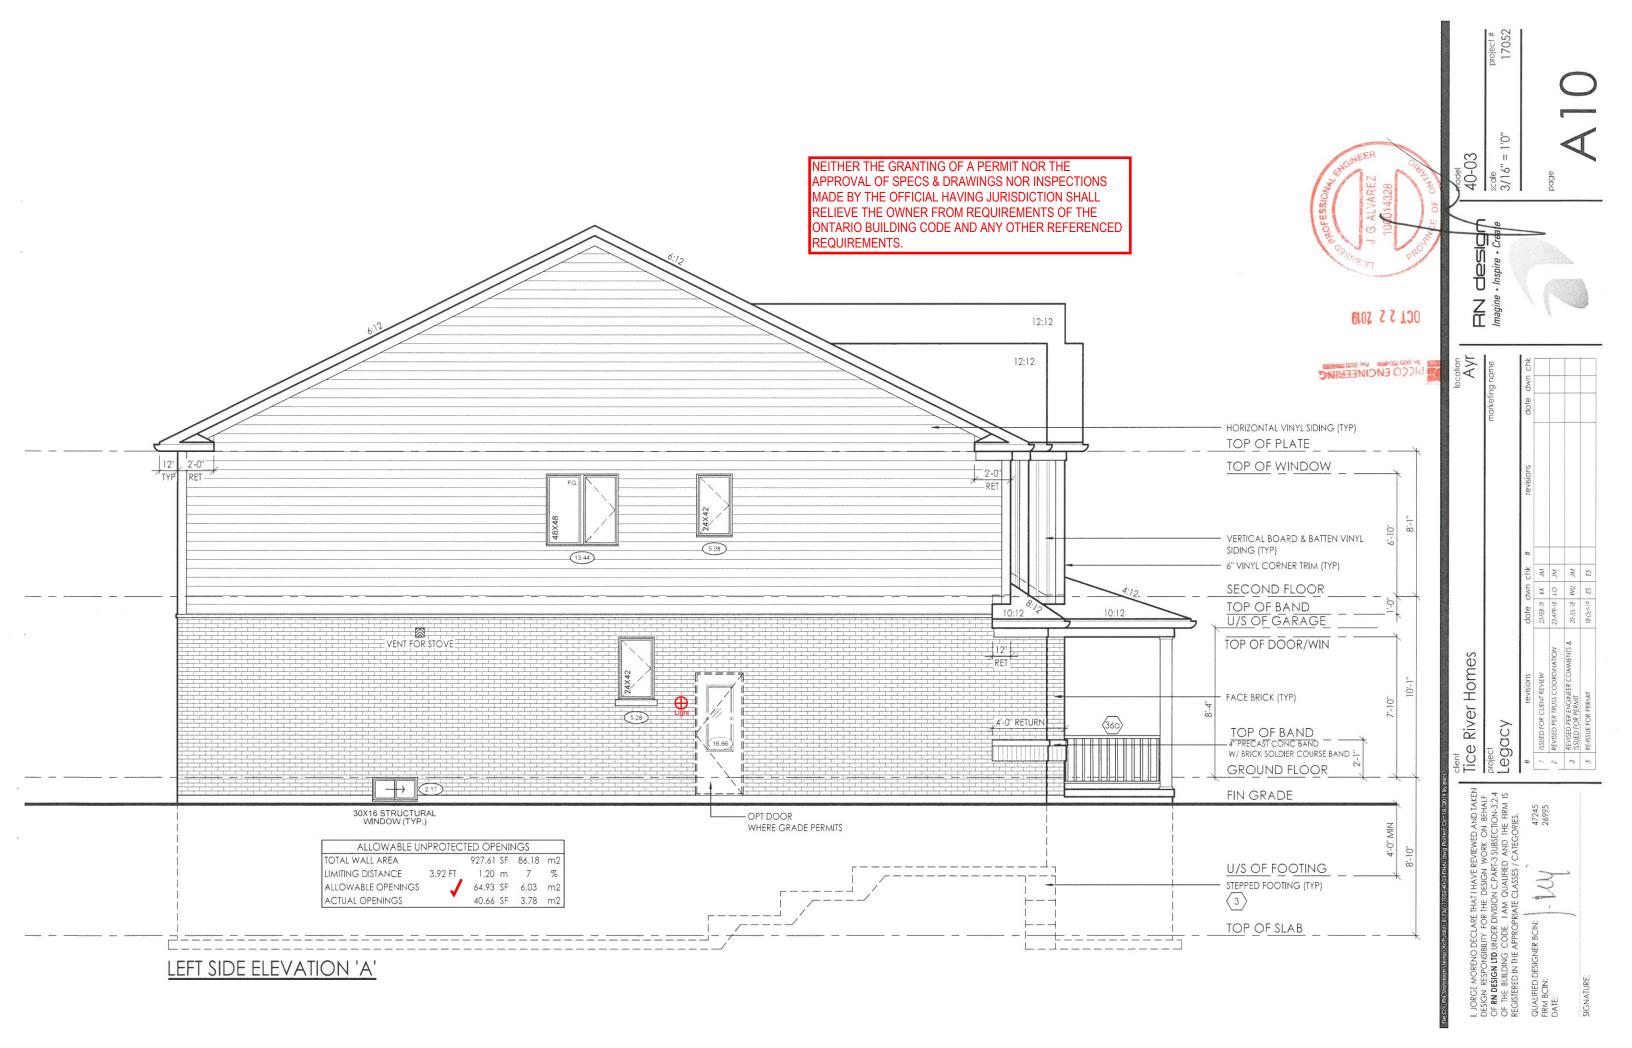

COMPLIANCE PACKAGE A1 - OBC 2012 - 2017 ENACTMENT

-ALL CONSTRUCTION TO CONFORM TO THE ONTARIO BUILDING CODE (O.B.C.) AND ALL OTHER CODES AND LOCAL AUTHORITIES HAVING JURISDICTION.

-ALL DIMENSIONS GIVEN FIRST IN IMPERIAL FOLLOWED BY METRIC.
-THERMAL RESISTANCE VALUES BASED ON ZONE 1

FOOTINGS / SLABS:

TYPICAL STRIP FOOTING:

O.B.C. 9.15.3. -BASED ON 16'-1"(4.9m) MAX. SUPPORTED JOIST LENGTH -MIN. 2200psi (15MPa) CONCRETE AFTER 28 DAYS -SHALL REST ON UNDISTURBED SOIL, ROCK OR COMPACTED GRANULAR FILL

W/ MIN. 10.9psi (75kPa) BEARING CAPACITY
-FTG. TO HAVE CONTINUOUS KEY

-FTG. SIZES MAY BE REDUCED FOR SOILS W/ GREATER BEARING CAPACITY (AS PER SOILS ENGINEERING REPORT)

-REFER TO WORKING DRAWINGS FOR SPECIFIC SIZES THAT MAY SUPERSEDE NOTES #1 & #2 FOR FOOTING SIZES

1 TYPICAL STRIP FOOTING: (EXTERIOR WALLS)

-FIG. TO EXTEND MIN. 4'-0" (1200mm) BELOW GRADE BRICK VENEER -1 STOREY - 13" X 4" (330mm X 1 -2 STOREY - 19" X 6" (485mm X 1

(330mm X 100mm) (485mm X 155mm) -3 STOREY - 26" X 9" (660mm X 230mm

-1 STOREY - 10" X 4" SIDING-(255mm X 100mm) -2 STOREY - 14" X 4" -3 STOREY - 18" X 5" (360mm X 100mm) (460mm X 130mm)

TYPICAL STRIP FOOTING: (INTERIOR BEARING WALLS)

-3 STOREY MASONRY - 36" X 14"

O.B.C. 9.15.3.6. -1 STOREY MASONRY -1 STOREY STUD - 16" X 4" - 12" X 4" (410mm X 100mm) (305mm X 100mm) - 26" X 9" - 18" X 5" (650mmX 230mm) (450mm X 130mm) -2 STOREY MASONRY -2 STOREY STUD

-3 STOREY STUD 3 STEP FOOTING:

- 24" X 8"

(900mm X 360mm)

DRAINAGE TILE OR PIPE:

O.B.C. 9.14.3. -4" (100mm) MIN. DIA. LAID ON UNDISTURBED OR WELL COMPARED SOWE THE C W/ TOP OF TILE OR PIPE TO BE BELOW BOTTOM OF FLR. SLAB.

-COVER TOP & SIDES OF TILE OR PIPE W/ 5 7/8" (150mm) OF CRUSHED ARIO BUILD STONE OR OTHER COURSE CLEAN GRANULAR MATERIAL. -tile shall drain to a sewer, drainage ditch, or dry wel<mark>l</mark>

5 BASEMENT SLAB:

O.B.C. 9.13. & 9.16.
-3" (75mm) CONCRETE SLAB
-2200psi (15MPa) AFTER 28 DAYS - O.B.C. 9.16.4.5.
-DAMPPROOF BELOW SLAB W/ MIN. 0.006" (0.15mm) POLYETHYLENE OR

TYPE 'S ROLL ROOFING W/ 4" (100mm) LAPPED JOINTS. -DAMPPROOFING MAY BE OMITTED IF CONCRETE HAS MIN. 3600psi(25MPa)

COMPRESSIVE STRENGTH AFTER 28 DAYS
-4" (100mm) OF COURSE GRANULAR MATERIAL
-PROVIDE BOND BREAKING MATERIAL BETWEEN SLAB & FTG.

-WHERE SLAB IS REQUIRED TO BE WATERPROOFED IT SHALL CONFORM TO O.B.C. $9.13.3. \ \,$ -FLOOR DRAIN PER O.B.C.9.31.4.4.

-R10 (RS1 1.76) INSULATION AT PERIMETER OF SLAB WHERE GRADE IS WITHIN 23-1/2" (600mm) OF BASEMENT SLAB EDGE. INSULATION TO EXTEND TO NOT LESS THAN 23-1/2" (600mm) BELOW EXTERIOR GRADE LEVEL (OBC SB-12 - UNLESS IT CAN BE DEMONSTRATED THAT SOIL GAS DOES NOT CONSTITUTE

A PROBLEM, SOIL GAS CONTROL SHALL CONFORM TO SUPPLEMENTARY STANDARD (O.B.C. SB-9)

$\langle 50 \rangle$ SLAB ON GROUND:

-3" (75mm) CONCRETE SLAB - O.B.C. 9.16.4.3. -2200psi (15MPa) AFTER 28 DAYS - O.B.C. 9.16.4.5. -DAMPPROOF BELOW SLAB W/ MIN. 0.006" (0.15mm) POLYETHYLENE OR TYPE 'S' ROLL ROOFING W/ 4" (100mm) LAPPED JOINTS.

-DAMPPROOFING MAY BE OMITTED IF CONCRETE HAS MIN. 3600psi(25MPa) COMPRESSIVE STRENGTH AFTER 28 DAYS -R10 (RSI 1.76) INSULATION UNDER ENTIRE SLAB WHERE THE ENTIRE SLAB IS

WITHIN 23-1/2" (600mm) OF GRADE. (OBC SB-12 3.1.1.7.(6)) -4" (100mm) OF COURSE GRANULAR MATERIAL -PROVIDE BOND BREAKING MATERIAL BETWEEN SLAB & FTG.

-WHERE SLAB IS REQUIRED TO BE WATERPROOFED IT SHALL CONFORM TO O.B.C. 9.13.3.

-FLOOR DRAIN PER O.B.C.9.31.4.4.
- UNLESS IT CAN BE DEMONSTRATED THAT SOIL GAS DOES NOT CONSTITUTE A PROBLEM, SOIL GAS CONTROL SHALL CONFORM TO SUPPLEMENTARY

STANDARD (O.B.C. SB-9)

GARAGE SLAB / EXTERIOR SLAB:
-4"(100mm) CONCRETE SLAB
-4650psi (32MPa) COMPRESSIVE STRENGTH AFTER 28 DAYS FOR UNREINFORCED CONC. & W/ 5-8% AIR ENTRAINMENT - O.B.C. 9.3.1.6. -6" X 6" (W2.9 X W 2.9) WIRE MESH LOCATED NEAR MID-DEPTH OF SLAB -4" (100mm) OF COURSE GRANULAR MATERIAL

-ANY FILL PLACED UNDER SLAB , OTHER THAN COURSE CLEAN GRANULAR MATERIAL, SHALL BE COMPACTED.

7 PILASTERS:

O.B.C. 9.15.5.3.

-CONCRETE NIB - 4" X 12" (100mm X 300mm) -BLOCK NIB - 4" X 12" (100mm X 300mm) BONDED & TIED TO WALL AS PER O.B.C. 9.20.11.2. TOP 7 7/8" (200mm) SOLID.

BEAM POCKET -4" (100mm) INTO FDN. WALL W/ WIDTH TO MATCH BEAM SIZE. -1/2" (13mm) SPACE AROUND WOOD BEAMS (O.B.C. 9.23.2.2.)

STRUCTURAL COLUMNS

-SIZES BASED ON COLUMN SUPPORTING BEAMS CARRYING LOADS FROM NOT MORE THAN 2 WOOD FRAME FLOORS, WHERE THE LENGTHS OF JOISTS CARRIED BY SUCH BEAMS DO NOT EXCEED 16'-1" (4.9m) AND THE LIVE LOAD ON ANY FLOOR DOES NOT EXCEED 50psf (2.4kPa).

8 STEEL PIPE COLUMN:

O.B.C. 9.15.3.4. & 9.17.3 -FIXED COLUMN

-MIN. 3 1/2" (90mm) DIA. W/ 3/16" (4.76mm) WALL THICKNESS -FOR STEEL BEAMS, CLIPS @ TOP & MIN. 6" X 4" X 1/4" (152mmX 100mmx

6.35mm) STEEL BTM. PLATE **FOR WOOD BEAMS, MIN. 4"X4"X1/4" (100mmX 100mm X 6.35mm) STEEL TOP & BTM. PLATES, OR TOP PLATE TO EXTEND MIN. WIDTH OF BEAM

-ADJUSTABLE COLUMNS TO CONFORM TO CAN//CGSB-7.2-M WHERE IMPOSED LOAD DOES NOT EXCEED 36 KN (O.B.C. 9.17.3.4.) COL. SPACING: FTG SIZE:

2 STOREY -MAX. 9'-10" (2997mm)

- 34" X 34" X 16" - (860mmX 860mmX 400mm) 44" X 44" X 21

-MAX. 16'-0" (4880mm) 3 STORFY

-MAX. 9'-10" (2997mm)

- (1010mmX 1010mmX 480mm) -MAX. 16'-0" (4880mm) 51" × 51" × 24"

(1295mmX 1295mmX 610mm) -WHERE COL. SITS ON FDN. WALL, USE 4" X 8" X 5/8" (100mmX 200mmX

16mm) STEEL PLATE WITH 2-5/8" (16mm) ANCHOR BOLTS

♦ CLIENT SPECIFIC REVISIONS

9 WOOD COLUMN:

OBC 9.17.4.1 . 9.17.4.2. & 9.17.4.3

-5 ½" x 5 ½" (140mm x 140mm) SOLID WOOD COLUMN - OR
-3-2"x6" (38mm x 140mm) BUILT UP COLUMN NAILED TOGETHER W/ 3" (76mm)
NAILS SPACED NOT MORE THAN 12" (300mm) APART OR BOLTED TOGETHER W/
3/8"(9.52mm) DIA BOLTS SPACED AT 18" (450mm) O.C.

-WRAP COLUMN BASE W/ 6 MIL POLY -COLUMN TO SIT DIRECTLY ON CONC PAD (NOT ON CONC SLAB) -25"x25"x12" (640mm x 640mm x 300mm) CONC PAD (1 FLOOR SUPPORTED W/ 9'-10" COL SPACING)

-34"x34"x14" (860mm x 860mm x 360mm) CONC PAD (2 FLOORS SUPPORTED W/ 9'-10" COL SPACING)

WALL ASSEMBLIES:

14 FOUNDATION WALL:

O.B.C. 9.15.4.2 -FOR WALLS NOT EXCEEDING 8'-2" (2500mm) IN LATERALLY SUPPORTED HEIGHT. -8" (200mm) SOLID 2200psi (15MPa) CONCRETE

-MAX. UNSUPPORTED HEIGHT OF 3-11" (1200mm) & MAX. SUPPORTED HEIGHT OF 7'-0" (2150mm) MEASURED FROM GRADE TO FINISHED BASEMENT FLOOR.

-FOR WALLS NOT EXCEEDING 9-0" (2750mm) IN LATERALLY SUPPORTED HEIGHT.
-10" (250mm) SOLID 2200psi (15MPa) CONCRETE
-MAX. UNSUPPORTED HEIGHT OF 4'-7" (1400mm) & MAX. SUPPORTED HEIGHT OF 8'-6" (2600mm) MEASURED FROM GRADE TO FINISHED BASEMENT FLOOR. -LATERAL SUPPORT PROVIDED BY ANCHORED SILL PLATE TO JOISTS.

-FOR CONDITIONS EXCEEDING THESE MAXIMUMS AN ALTERNATIVE IN CONFORMANCE TO O.B.C.- T.9.15.4.2.A SHALL BE USED OR IT SHALL BE DESIGNED UNDER O.B.C.- PART 4

-WALL SHALL EXTEND A MIN. 5 7/8" (150mm) ABOVE GRADE -INSULATE W/ R20 (RSI 3.52) CONTINUOUS INSULATION FROM UNDERSIDE OF

SUBFLOOR TO NOT MORE THAN 8" (200mm) ABOVE FINISHED FLOOR OF BASEMENT (ZONE 1 OBC SB-12 T.3.1.1.2.A.)

- ALTERNATE INSULATION METHOD: 2" (51mm) R10 (RSI 1.76)RIGID INSULATION W/ 2"x4"(38mm X 89mm) WOOD STUD W/ R12 (RSI 2.11) BATT INSULATION -BACK FILL W/ NON-FROST SUSCEPTIBLE SOIL REDUCTION OF THICKNESS:

O.B.C. 9, 15, 4.7. -WHERE THE TOP OF THE FOUNDATION WALL IS REDUCED IN THICKNESS TO ALLOW MASONRY FACING, THE MIN. REDUCED THICKNESS SHALL NOT BE LESS

O.B.C. 9.15.3.9.

THAN 3-1/2' (90mm) THICK.

-23 5/8" (600mm) MAX. VERTICAL RISE & 23 5/8" (600mm) MIN. THE GRIATOFIACIDE FACED MAX. @ 7 7/8" (200mm) APPROVAL OF SPIESANCE BETWEEN WARDAND HORIZOTHALLY OF SPIESANCE BETWEEN WARDAND HORIZOTHALLY ON A 2001 HILL BE WARDAND HORIZOTHALLY OF THICKNESS SHALL BE REPLY THE OWNER FROM REQUIREMENTS OF THE REPLY OF THE REPLY

WHER FROM REQUIREMENTS OF THE DAMPPROOFING & WATERPROOFING:

DAMPPROOF THE EXTERIOR FACE OF WALFBELOW GRADE AS PER O.B.C. REQUIREMENTS, 13.2.

WHERE INSULATION EXTENDS TO MORE THAN 2'-11" (900mm) BELOW GRADE A FDN. WALL DRAINAGE LAYER SHALL BE PROVIDED IN CONFORMANCE TO

O.B.C. 9.14.2.1.(2) (3) (4) -FINISHED BASEMENTS SHALL HAVE INTERIOR DAMPPROOFING EXTENDING FROM SLAB TO GRADE LEVEL & SHALL CONFORM TO O.B.C. 9.13.2.6.(2) (b) -WHERE HYDROSTATIC PRESSURE OCCURS, FDN. WALLS SHALL BE WATERPROOFED AS PER O.B.C. 9.13.3. -WALLS THAT ARE WATERPROOFED DO NOT REQUIRE DAMPPROOFING.

140 FOUNDATION WALLS @ UNSUPPORTED OPENINGS:

-2-20M BARS IN TOP PORTION OF WALL (UP TO 8'-0" OPENING) -3-20M BARS IN TOP PORTION OF WALL (8"-0" TO 10"-0" OPENING)
-4-20M BARS IN TOP PORTION OF WALL (10"-0" TO 15"-0" OPENING)
-BARS STACKED VERTICALLY AT INTERIOR FACE APPROX 4" TO 6" APART. -BARS TO HAVE MIN. 2" (50mm) CONCRETE COVER -BARS TO EXTEND 2"-0" (600mm) BEYOND BOTH SIDES OF OPENING.

15 FRAME WALL CONSTRUCTION:

O.B.C. 9.23. -SIDING OR STUCCO AS PER ELEVATIONS, MIN. 7 7/8" (200mm) FROM FINISHED GRADE (O.B.C. 9.28.1.4. & 9.27.)

-WALL SHEATHING MEMBRANE AS PER O.B.C. 9.27.3.2.
-1/4" (6mm) PLYWOOD (EXTERIOR TYPE) OR EQUIVALENT AS PER O.B.C. 9.23.16.
-2" X 6" (38mm X 140mm) WOOD STUDS @ 16" (400mm) O.C.
-MIN. R22 (RSI 3.87) INSULATION (ZONE 1. OBC SB-12 T.3.1.1.2.A.)
-CONTINUOUS AIR/VAPOUR BARRIER IN CONFORMANCE W/ O.B.C. 9.25.3. & 9.25.4.

-1/2" [12.7mm] GYPSUM BOARD NOTE - SUPPORT FOR 3 FLOORS ABOVE - O.B.C. T.9.23.10.1.

-FOR 3 FLOORS SUPPORTED ABOVE, 2" X 6" (38mmX 140mm) STUDS ARE REQUIRED TO BE SPACED @ 12" (300mm) O.C.

REQ. FOR FIRE RATING (LESS THAN 4'-0" LIMITING DISTANCE):

O.B.C. SB-3 WALL = EW1b (STC = N/A, FIRE = 45 MIN) FOR 45 MINUTE FIRE RATED WALL REQUIREMENTS SUBSTITUTE THE FOLLOWING MATERIALS

-REPLACE R22 (RSI 3.87) INSULATION WITH R22 (RSI 3.87) ABSORPTIVE INSULATING MATERIAL WITH A MASS OF AT LEAST 4.8 kg/ sq.m. -REPLACE 1/2" (12.7mm) INTERIOR GYPSUM BOARD WITH 1/2" (12.7mm) TYPE

REQ. FOR FIRE RATING (LESS THAN 2'-0" LIMITING DISTANCE):

REFER TO REQUIREMENTS FOR LESS THAN 4'-0" LIMITING DISTANCE AND ADD/REPLACE THE FOLLOWING:
-NON-COMBUSTABLE SIDING OR STUCCO AS PER ELEVATIONS (REFER TO

MANUFACTURER'S SPECIFICATIONS). -VINYL SIDING IS PERMITTED PER O.B.C. 9.10.15.5.(3). OVER 1/2" (12.7mm

GYPSUM EXTERIOR SHEATHING WHICH REPLACES EXTERIOR PLYWOOD OR EQUIV.

(15b) FRAME WALL CONSTRUCTION @ GARAGE:

O.B.C. 9.23.
-SIDING OR STUCCO AS PER ELEVATIONS, MIN. 7 7/8" (200mm) FROM FINISHED GRADE (O.B.C. 9.28.1.4. & 9.27.)
-WALL SHEATHING MEMBRANE AS PER O.B.C. 9.27.3.2.

-1/4" (6mm) PLYWOOD (EXTERIOR TYPE) OR EQUIVALENT AS PER O.B.C. 9.23.16.

-2" X 4" (38mmX 89mm) WOOD STUDS @ 16" (400mm) O.C.

-1/2" (12.7mm) GYPSUM BOARD NOTE - SUPPORT FOR 2 + 3 FLOORS ÁBOVE - O.B.C. T.9.23.10.1. = -FOR 2 FLOORS SUPPORTED ABOVE, 2" X 4" (38mmX 89mm) STUDS ARE REQUIRED TO BE SPACED @ 12" (300mm) O.C. -FOR 3 FLOORS SUPPORTED ABOVE, 2" X 6" (38mmX 140mm) STUDS ARE

REQUIRED TO BE SPACED @ 12" (300mm) O.C. REQ. FOR FIRE RATING (LESS THAN 4'-0" LIMITING DISTANCE):

O.B.C. SB-3 WALL = EW1b (STC = N/A, FIRE = 45 MIN) FOR 45 MINUTE FIRE RATED WALL REQUIREMENTS SUBSTITUTE AND/OR ADD THE FOLLOWING MATERIALS:

ADD ABSORPTIVE MATERIAL WITH A MASS OF AT LEAST 2.8 kg/ sq.m. -REPLACE 1/2"(12.7mm) GYPSUM BD. W/ 1/2" (12.7mm) TYPE 'X' GYPSUM BD. REQ. FOR FIRE RATING (LESS THAN 2'-0" LIMITING DISTANCE):

-REFER TO REQUIREMENTS FOR LESS THAN 4'-0" LIMITING DISTANCE AND

ADD/REPLACE THE FOLLOWING:
-NON-COMBUSTABLE SIDING OR STUCCO AS PER ELEVATIONS (REFER TO MANUFACTURER'S SPECIFICATIONS).

-VINYL SIDING IS PERMITTED PER O.B.C. 9.10.15.5.(3). OVER SHEATHING PAPER OVER 1/2" (12.7mm) GYPSUM EXTERIOR SHEATHING WHICH REPLACES EXTERIOR PLYWOOD OR EQUIV.

BRICK VENEER CONSTRUCTION:

O.B.C. 9.23. -3-1/2" (90mm) FACE BRICK OR 4" (100mm) STONE @ 36'-1" (11m) MAX.

MIN. 0.03" (0.76mm) THICK, 7/8" (22mm) WIDE CORROSION RESISTANT STRAPS @ MAX. 15 3/4" (400mm) O.C. HORIZONTAL & 23 5/8" (600mm) O.C. VERTICAL SPACING
-PROVIDE WEEP HOLES @ 2'-7" (800mm)O.C. @ BTM. COURSE & OVER

OFEININGS -BASE FLASHING UP TO 5 7/8" (150mm) BEHIND WALL SHEATHING MEMBRANE (O.B.C., 9.20.13.6.(2))

-BRICK OR STONE SILLS UNDER OPENINGS, FLASHING UNDER -1" (25mm) AIR SPACE - NALL SHEATHING MEMBRANE AS PER O.B.C. 9.27.3.2. -1/4" (6mm) PLYWOOD (EXTERIOR TYPE) OR EQUIVALENT AS PER O.B.C.

7-25-16 -72" X 6" (38mmX 140mm) WOOD STUDS @ 16" (400mm) O.C. -MIN. R22 (RSI 3.87) INSULATION (ZONE 1. OBC SB-12 T.3.1.1.2.A.) -CONTINUOUS AIR/VAPOUR BARRIER IN CONFORMANCE W/ O.B.C.- 9.25.3. & 9.25.4.

-1/2" (12.7mm) GYPSUM BOARD

NOTE - SUPPORT FOR 3 FLOORS ABOVE - O.B.C. T.9.23.10.1, = -FOR 3 FLOORS SUPPORTED ABOVE, 2" X 6" (38mmX 140mm) STUDS ARE REQUIRED TO BE SPACED @ 12" (300mm) O.C.

REQ. FOR FIRE RATING (LESS THAN 4'-0" LIMITING DISTANCE):

O.B.C. SB-3 WALL = EW1b (STC = N/A, FIRE = 45 MIN) FOR 45 MINUTE FIRE RATED WALL REQUIREMENTS SUBSTITUTE AND/OR ADD THE FOLLOWING MATERIALS:

-REPLACE R22 (RSI 3.87) INSULATION WITH R22 (RSI 3.87) ABSORPTIVE INSULATING MATERIAL WITH A MASS OF AT LEAST 4.8 kg/ sq.m. -REPLACE 1/2"(12.7mm) GYPSUM BD. W/ 1/2" (12.7mm) TYPE "X" GYPSUM BD.

(16b) BRICK VENEER CONSTRUCTION @ GARAGE:

O.B.C. 9.23. -3-1/2" (90mm) FACE BRICK OR 4" (100mm) STONE @ 36'-1" (11m) MAX.

-MIN. 0.03" (0.76mm) THICK, 7/8" (22mm) WIDE CORROSION RESISTANT STRAPS @ MAX. 15 3/4" (400mm) O.C. HORIZONTAL & 23 5/8" (600mm) O.C. VERTICAL SPACING PROVIDE WEEP HOLES @ 2'-7" (800mm)O.C. @ BTM. COURSE & OVER

OPENINGS -BASE FLASHING UP TO 5 7/8" (150mm) BEHIND WALL SHEATHING MEMBRANE (O.B.C. 9.20.13.6.(2))

-BRICK OR STONE SILLS UNDER OPENINGS, FLASHING UNDER -1" (25mm) AIR SPACE

-WALL SHEATHING MEMBRANE AS PER O.B.C. 9.27.3.2 -1/4" (6mm) PLYWOOD (EXTERIOR TYPE) OR EQUIVALENT AS PER O.B.C.

9.23.16

7.23.10
2" X 4" (38mmX 89mm) WOOD STUDS @ 16" (400mm) O.C.
-1/2" (12.7mm) GYPSUM BOARD
NOTE - SUPPORT FOR 2 + 3 FLOORS ABOVE - O.B.C. 1.9.23.10.1. =
-FOR 2 FLOORS SUPPORTED ABOVE, 2" X 4" (38mmX 89mm) STUDS ARE
REQUIRED TO BE SPACED @ 12" (300mm) O.C. -FOR 3 FLOORS SUPPORTED ABOVE, 2" X 6" (38mmX 140mm) STUDS ARE REQUIRED TO BE SPACED @ 12" (300mm) O.C.

REQ. FOR FIRE RATING (LESS THAN 4'-0" LIMITING DISTANCE):

O.B.C. SB-3 WALL = EW1b (STC = N/A, FIRE = 45 MIN) FOR 45 MINUTE FIRE RATED WALL REQUIREMENTS SUBSTITUTE AND/OR ADD THE FOLLOWING MATERIALS: -ADD R15 (RSI 2.64) ABSORPTIVE MATERIAL WITH A MASS OF AT LEAST 2.8 kg/

-REPLACE 1/2"(12.7mm) GYPSUM BD. W/ 1/2" (12.7mm) TYPE 'X' GYPSUM BD.

17 INTERIOR STUD WALLS:

O.B.C. T.9.23.10.1. -2" X 4" (38mmX 89mm) WOOD STUDS @ 16" (400mm) O.C. OR -2" X 6" (38mmX 140mm) WOOD STUDS @ 16" (400mm) O.C. W/ - DOUBLE 2" X 4" OR 2" X 6" TOP PLATES AND SINGLE BOTTOM PLATE -1/2" (12.7mm) GYPSUM BOARD BOTH SIDES.

BEARING STUD WALL (BASEMENT):

-2" X 4" (38mmX 89mm) WOOD STUDS @ 16" (400mm) O.C. OR -2" X 6" (38mmX 140mm) WOOD STUDS @ 16" (400mm) O.C. W/ - DBL. 2" X 4" OR 2" X 6" TOP PLATE. -2" X 4" OR 2" X 6" BOTTOM PLATE ON DAMPPROOFING MATERIAL. -1/2" (12.7mm) GYPSUM BOARD BOTH SIDES.

-1/2" (12.7mm) DIA. ANCHOR BOLTS @ 7-10" (2400mm) O.C. -FOOTING AS PER GENERAL NOTE #2 W/4" CONC. CURB

(22) GARAGE WALL & CEILING:

O.B.C. 9.10.9.16.(3) -1/2" (12.7mm) GYPSUM BOARD ON BOTH SIDES OF WALL & U/S OF CEILING BETWEEN HOUSE AND GARAGE -TAPE AND SEAL ALL JOINTS GAS TIGHT

-R22 (RSI 3.87) INSULATION IN WALLS,
-R31 (RSI 5.41) INSULATION IN CEILINGS W/ FLOOR ABOVE
-CONTINUOUS AIR/VAPOUR BARRIER IN CONFORMANCE W/ O.B.C.9.25.3. & 9.25.4.. FOR FLOOR ABOVE.

-INSULATION AROUND DUCTS AND PIPING NOT TO ENCROACH MIN. REQUIRED GARAGE AREA (REFER TO MUNICIPAL STANDARDS). -1/2" (12.7mm) GYPSUM BOARD -ROOF FRAMING MEMBERS ARE FASTENED TO TOP PLATES WITH

4 - 3 1/4" (82mm) TOE NAILS -BOTTOM PLATES ARE FASTENED TO FLOOR JOISTS, BLOCKING OR RIM JOIST WITH 3 1/4" (82mm) NAILS AT 7 7/8" (200mm) O.C.

WALLS ADJACENT TO ATTIC SPACE:

-1/2" (12.7mm) GYPSUM BOARD -CONTINUOUS AIR/VAPOUR BARRIER IN CONFORMANCE W/ O.B.C.-9.25.3. & 9.25.4. -2" X 6" (38mmX 140mm) WOOD STUDS @ 16" (400mm) O.C.

-R22 (RSI 3.87) INSULATION
-1/2" (12.7mm) GYPSUM BOARD OR 1/4" (6mm) PLYWOOD SHEATHING ON ATTIC SIDE.

-ATTIC ACCESS TO BE PROVIDED AS PER O.B.C. 9.19.2.1.

23 DOUBLE VOLUME WALLS:

O.B.C. 9.23.10.1.

-3/8" (9.5mm) PLYWOOD, OSB OR WATERBOARD SHEATHING
-REFER TO PLAN FOR STUD SPECIFICATION
-STUDS FASTENED AT TOP & BOTTOM WITH 3/3-1/4" (82mm) TOE NAILS -DOUBLE TOP PLATES FASTENED TOGETHER WITH 3" (76mm) AT 7 7/8" (200mm) O.C. -SOLID BRIDGING AT 3'-11" (1200mm) O.C. -MIN. R22 (RSI 3.87) INSULATION (ZONE 1 OBC SB-12 T.3.1.1.2.A.) -CONTINUOUS AIR/VAPOUR BARRIER IN CONFORMANCE WITH O.B.C.

9.25.3. & 9.25.9.

 $\langle 24 \rangle$ EXPOSED FLOOR: -FLOOR AS PER NOTE # 28 -CONTINUOUS AIR/VAPOUR BARRIER IN CONFORMANCE W/ O.B.C.- 9.25.3. & 9.25.4. -R31 (RSI 5.46) INSULATION

SUNKEN FINISHED AREAS:

-VENTED ALUMINUM SOFFIT

-USE SOLID BUILT-UP WOOD BEARING POST TO SUPPORT SUNKEN AREA - USE OF THE SUME ARE AT FOUNDATION WALLS. EXTEND FOOTINGS TO SUPPORT SURFACE ARE AT FOUNDATION WALLS. EXTEND FOOTINGS TO SUPPORT POSTS.


- WHERE GRADING CONDITIONS WILL ALLOW, CHECK FOUNDATION WALLS INSTEAD OF USING BEARING POSTS.

-FLOOR STRUCTURE AS PER NOTE # 28.



HESE DRAWINGS ARE NOT TO BE SCALED. ALL DIMENSIONS MUST BE VERIFIED BY CONTRACTOR PRIOR TO COMMENCEMENT OF ANY WORK OR PRIOR TO COMMENCEMENT OF ANY WORK EPORTED DIRECTLY TO RN DESIGN LTD ANY DISCREPANCIES



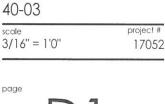

I, JORGE MORENO DECLARE THAT I HAVE REVIEWED AND TAKEN DESIGN RESPONSIBILITY FOR THE DESIGN WORK ON BEHALF OF RN DESIGN LTD.UNDER DIVISION C,PART-3 SUBSECTION-3.2.4 OF THE BUILDING CODE. I AM QUALIFIED AND THE FIRM IS REGISTERED IN THE APPROPRIATE CLASSES / CATEGORIES.

QUALIFIED DESIGNER BCIN: DATE:

SIGNATURE:

47245

- (1120mmX 1120mmX 530mm)

AMMENDMENT O. REG. 139/17 JAN 1, 2018

project

Tice River Homes

date dwn chk revisions revisions REVISED PER TRUSS COORDINATION 23-APR-18 LO REVISED PER ENGINEER COMMENTS & ISSUED FOR PERMIT 20-JUL-18 WU JM RE-ISSUE FOR PERMIT 18-Oct-19 ES ES

Legacy date dwn chk

Ayr

marketing name

page

O.B.C. 9.20.8.2.

-3 1/2" MASONRY VENEER ON 2" MORTAR JOINT ON 3 1/2" MASONRY VENEER
-WYTHES TO BE TIED W/ METAL TIES INSTALLED AS PER O.B.C. 9.20.9.4. SILL PLATE REQUIRED FOR ROOF AND CEILING FRAMING MEMBERS
-6" SILL W/ 2" BEARING ON EACH SIDE & ANCHOR BOLTS @ 4"-0" O.C.
NOTE: MASONRY TO BE SOLID & MORTAR JOINT FILLED SOLID FOR FLOOR JOISTS BEARING ON WYTHES. FLOOR JOISTS ARE NOT TO PROJECT INTO CAVITY

25a CORBEL MASONRY VENEER:

-MASONRY VENEER TO BE CORBELLED AS PER O.B.C. 9.20.12.3.(1)

FLOOR ASSEMBLIES:

(26) SILL PLATE:

-2" X 4" (38mm X 89mm) PLATE -1/2" (12.7mm) DIA. ANCHOR BOLTS @ 7'-10" (2400mm) O.C. FASTENED TO PLATE W/ NUTS AND WASHERS & SHALL BE EMBEDDED NOT LESS THAN 4"

(100mm) INTO FOUNDATION WALL.
-SILL PLATE TO BE CAULKED, OR PLACED ON A LAYER NOT LESS THAN 1 (25mm) THICK BEFORE COMPRESSING, OR FOAM GASKET, OR PLACED ON FULL BED OF MORTAR.

27 BRIDGING & STRAPPING:

O.B.C. 9.23.9.4. a) STRAPPING

-I" X 3" (19mmX 64mm) NAILED TO U/S OF JOISTS @ MAX. 6'-11" (2100mm) O.C. -FASTENED TO SILL OR HEADER @ ENDS

b) BRIDGING -1" X 3" (19mmX 64mm) OR 2" X 2" (38mmX 38mm) CROSS BRIDGING @ MAX.

6'-11" (2100mm) O.C. c) BRIDGING & STRAPPING

- a) & b) USED TOGETHER OR

-1 1/2" (38mm) SOLID BLOCKING @ MAX. 6'-11" (2100mm) O.C. USED WITH

-TITY (SAMM) SOLID BLOCKING & MAX. 6-11" (2100mm) O.C. USED WITH STRAPPING (a)

d) FURRING OR PANEL TYPE CEILING
-STRAPPING NOT REQUIRED IF FURRING STRIPS OR PANEL TYPE CEILING FINISH IS ATTACHED DIRECTLY TO JOISTS.

28 FLOOR ASSEMBLY:

O.B.C. 9.23.14.3, 9.23.14.4 -5/8" (15.9mm) WAFERBOARD (R-1 GRADE) OR EQUIVALENT -FLOOR JOISTS AS PER FLOOR PLANS

29 PORCH SLAB:

30 EXTERIOR BALCONY ASSEMBLY:

EXTERIOR BALCONY ASSEMBLY:

-1 1/4"X 3 1/2" PRESSURE TREATED DECKING W/ 1/4" SPACING

-2"X4" WOOD PURLINS (CUT DIAGONALLY) @ 12" O.C. LAYING UNFAST EDIEDTARIO BUILDING BIC JOIL AND ANY OTHER REFERENCED

ON SINGLE PLY WATERPROOF ROOF MEMBRANE OR EQUIVALENT ON SAST UNREMEMBED BUILDING BIC JOIL AND PROJECTIONS BELOW HANDRAILS INCLUDING STEP

(15.9mm) EXTERIOR GRADE PLYWOOD SHEATHING ON 2"X4" WOOD PUREMENT STRINGERS TO PROJECT A MAXIMUM OF 4" (100mm) INTO THE REQUIRED

(CUT DIAGONALLY) @ 12" O.C. DIRECTLY ON 2"X8" ROOF JOISTS @ 12" O.C.

WIDTH OF THE STAIR (OR AS NOTED ON PLAN)

- EXTERIOR GUARD AS PER #36a - SLOPE ASSEMBLY MINIMUM 2% TO ROOF SCUPPER

REQUIRED FOR OVER HEATED SPACES:

ADD 2"x2" (38mm x 38mm) CROSS PURLINS @ 16" (400mm) O.C. FOR VENTILATION OVER JOISTS (OBC 9.19.1.2. VENTING NOT LESS THAN 1/150 OF CEILING AREA)
-ADD R31 (RSI 5.46) INSULATION BETWEEN JOISTS

-ADD CONTINUOUS AIR/VAPOUR BARRIER IN CONFORMANCE W/ O.B.C. 9.25.3.

-ADD 1/2" (12.7mm) GYPSUM BOARD W/ PAINTED CEILING OR -ADD 5/8" (15.9mm) GYPSUM BOARD W/ TEXTURED CEILING (O.B.C.-T.9.29.5.3.)

300 EXTERIOR FLAT ROOF ASSEMBLY:

-SINGLE PLY WATERPROOF ROOF MEMBRANE OR EQUIVALENT INSTALLED PER MANUFACTURER'S SPECIFICATIONS.
-1/4" EXTERIOR GRADE WOOD PANEL TYPE UNDERLAY TAPERED PURLINS

SLOPED MIN. 2% TO ROOF SCUPPER.
-3/8" EXTERIOR GRADE PLYWOOD SHEATHING ON

-2"X8" ROOF JOISTS @ 12" O.C. (OR AS NOTED ON PLAN)

REQUIRED FOR OVER HEATED SPACES:

-ADD 2"x2" (38mm x 38mm) CROSS PURLINS @ 16" (400mm) O.C. FOR VENTILATION OVER JOISTS (OBC 9.19.1.2. VENTING NOT LESS THAN 1/150 OF

-ADD R31 (RSI 5.46) INSULATION BETWEEN JOISTS
-ADD CONTINUOUS AIR/VAPOUR BARRIER IN CONFORMANCE W/ O.B.C. 9.25.3.
& 9.25.4.

6 7.23-4. -ADD 1/2" (12.7mm) GYPSUM BOARD W/ PAINTED CEILING OR -ADD 5/8" (15.9mm) GYPSUM BOARD W/ TEXTURED CEILING (O.B.C. T.9.29.5.3.)

ROOF ASSEMBLIES

(31) TYPICAL ROOF:

O.B.C. 9.26.

-NO. 210 (30. 5KG/m2) ASPHALT SHINGLES
-FOR ROOFS BETWEEN 4:12 & 8:12 PITCH PROVIDE EAVES PROTECTION TO EXTEND UP THE ROOF SLOPE MIN. 2"-11" (900mm) FROM EDGE TO A LINE NOT LESS THAN 12" (300mm) PAST THE INSIDE FACE OF EXTERIOR WALL.
-EAVES PROTECTION LAID BENEATH STARTER STRIP.

-STARTER STRIP AS PER O.B.C. 9.26.7.2.

-STARTER STRIP NOT REQUIRED AS PER O.B.C. 9.26.7.2.(3)
-3/8" (10mm) PLYWOOD SHEATHING OR OSB (0-2 GRADE) WITH "H" CLIPS
-APPROVED WOOD TRUSSES @ 24" (600mm) O.C. (REFER TO MANUFACTURER'S

LAYOUT) -TRUSS BRACING AS PER TRUSS MANUFACTURER

-EAVESTROUGH ON PREFINISHED FASCIA AND VENTED SOFFIT (VINYL OR

-ATTIC VENTILATION 1:300 OF INSULATED CEILING AREA WITH, 50% AT SOFFIT.

CEILING:

-R60 (RSI 10.56) INSULATION -CONTINUOUS AIR/VAPOUR BARRIER IN CONFORMANCE W/ O.B.C. 9.25.3.

-1/2" (12.7mm) GYPSUM BOARD W/ PAINTED CEILING OR -5/8" (15.9mm) GYPSUM BOARD W/ TEXTURED CEILING (O.B.C. T.9.29.5.3.)

320 VAULTED OR CATHEDRAL CEILING:

O.B.C. 9.26. & TABLE A4 -NO. 210 (30. 5KG/m2) ASPHALT SHINGLES

-NO. 210 (30. SKG/M2) ASPHALT SHINGLES
-FOR ROOFS BETWEEN 4:12 & 8:12 PITCH PROVIDE EAVES PROTECTION TO
EXTEND UP THE ROOF SLOPE MIN. 2"-11" (900mm) FROM EDGE TO A LINE NOT
LESS THAN 12" (300mm) PAST THE INSIDE FACE OF EXTERIOR WALL.
-EAVES PROTECTION LAID BENEATH STARTER STRIP.

-EAVE PROTECTION NOT REQUIRED OVER UNHEATED SPACES OR WHERE ROOF SLOPES ARE 8:12 OR GREATER PER O.B.C. 9.26.5.1.
-STARTER STIPL AS PER O.B.C. 9.26.7.2.
-STARTER STRIP NOT REQUIRED AS PER O.B.C. 9.26.7.2.(3)

-3/8" (10mm) PLYWOOD SHEATHING OR OSB (0-2 GRADE) WITH "H" CLIPS. -2"x8" (38mm x 184mm) @ 16" O.C. W/ 2"x2" (38mm x 38mm) CROSS PURLINS @ 24" O.C. MAX. SPAN 13"-3" (4050mm) OR -2"x10" (38mm x 235mm) @ 16" O.C. W/ 2"x2" (38mm x 38mm) CROSS

PURLINS @ 24" O.C. MAX. SPAN 17'-0" (5180mm)

-MIN. 3" CLEARANCE FROM U/S OF ROOF SHEATHING TO INSULATION

-CONTINUOUS AIR/VAPOUR BARRIER IN CONFORMANCE WITH O.B.C. 9.25.3. & 9.25.4.

-1/2" (12.7mm) GYPSUM BOARD

♦ CLIENT SPECIFIC REVISIONS

(33) CONVENTIONAL FRAMING:

O.B.C. TABLE A6 OR A7

-2" X 6" (38mm X 140mm) RAFTERS @ 16" (400mm) O.C. MAX. SPAN 12'-9"

-2"X4" (38mm X 89mm) COLLAR TIES AT MIDSPANS -CEILING JOISTS TO BE 2" X 6" (38mmX 140mm) @ 16" (400mm) O.C. UNLESS OTHERWISE NOTED.

-HIP & VALLEY RAFTERS TO BE MIN. 2" (50mm) LARGER THAN COMMON RAFTERS & MIN. 1 1/2" (38mm) THICK.

34) ATIIC ACCESS HATCH:

OBC 9.19.2.1. & SB-12 3.1.1.8.(1)

-19 3/4" X 27 1/2" (500mm X 700mm) ATTIC HATCH WITH WEATHERSTRIPPING & BACKED W/ R20 (RSI 3.52) INSULATION.

GENERAL:

$\langle 35 \rangle$ PRIVATE STAIRS:

O.B.C. 9.8.4. (200mm) (210mm) -MIN. RUN = 8-1/4" -MIN. TREAD -MAX. NOSING (25mm) -MIN. HEADROOM = 6'-5 -MIN. WIDTH = 2'-1 (BETWEEN WALL FACES) 2'-10" (860mm)

-MIN. WIDTH = 2'-11" (9 (EXIT STAIRS, BETWEEN GUARDS)

ANGLED TREADS: -MIN. AVG. RUN

-MIN. AVG. RUN = 7.7/8" (200mm) -FINISHED RAILING ON WOOD PICKETS MAX. 4" BETWEEN PICKETS -EXTERIOR CONC. STEPS TO HAVE MIN. 9.1/4" (235mm) TREAD & MAX. 7 7/8" (200mm) RISE

FFIG. FOR FOUND. WALL TO BE MIN. 4'-0" (1220mm) BELOW GRADE

-ONE HANDRAIL REQUIRED WHERE STAIR WIDTH IS LESS THAN 3-7" (1100mm) -TWO HANDRAILS REQUIRED WHERE STAIR WIDTH EXCEEDS 3-7" (1100mm) -ONE HANDRAIL IS REQUIRED ON CURVED STAIRS OF ANY WIDTH WITHIN

-HANDRAILS ARE TO BE CONTINUOUS EXCEPT WHERE INTERRUPTED BY DOOR

PORCH SLAB:

O.B.C. 9.39.1.4.

WAYS, LANDINGS ON SOLUTIONS ON SLAB WITH 5 TO 8% AIR ENTRAINMENT REINFORCE WITH 10M BARS @ 7 7/8" (200mm) EACH WAY HEIGHT:

-1 1/4" (30mm) CLEAR COVER FROM THE BOTTOM OF THE SLAB -3" (75mm) END BEARING ON FOUNDATION WALL -23 5/8" (600mm) X 23 5/8" (60

(350) PUBLIC STAIRS:

O.B.C. 9.8.4. = 7-3/32 (180mm) (280mm) -MIN. RUN = 11" -MIN. TREAD (280mm) -MAX. NOSING (25mm) -MIN. HEADROOM = 6'-9" -MIN. WIDTH = 2'-11" (900mm)

-FOUND. WALL REQUIRED WHEN NUMBER OF RISERS EXCEEDS 2 -FTG. FOR FOUND. WALL TO BE MIN. 4'-0" (1220mm) BELOW GRADE

-ONE HANDRAIL REQUIRED WHERE STAIR WIDTH IS LESS THAN 3-7" (1100mm) -TWO HANDRAILS REQUIRED WHERE STAIR WIDTH EXCEEDS 3-7" (1100mm) -TWO HANDRAILS ARE REQUIRED ON CURVED STAIRS OF ANY WIDTH -HANDRAILS ARE TO BE CONTINUOUS INCLUDING AT LANDINGS EXCEPT WHERE INTERRUPTED BY DOOR WAYS OR NEWEL POSTS AT CHANGES IN

HEIGHT: O.B.C. 9.8.7.4 - 2-10" (865mm) MIN. TO 3'-2" (965mm) MAX. - 3"-6" (1070mm) WHERE GUARDS ARE REQUIRED ON LANDINGS) - MEASURED VERTICALLY FROM THE TOP OF THE HANDRAIL TO A STRAIGHT LINE DRAWN FROM THE TANGENT TO THE TREAD NOSING

PROJECTIONS: O.B.C. 9.8.7.6

- HANDRAILS AND PROJECTIONS BELOW HANDRAILS INCLUDING STEP STRINGERS TO PROJECT A MAXIMUM OF 4" (100mm) INTO THE REQUIRED WIDTH OF THE STAIR

TERMINATION:
O.B.C. 9.8.7.3
- ONE HAND RAIL SHALL EXTEND HORIZONTALLY NOT LESS THAN 11.3/4"

(300mm) BEYOND THE TOP & BOTTOM OF EACH STAIR

FINISH:

O.B. C. 9.8.9.6

-TREADS ARE TO BE WEAR AND SUP RESISTANT, SMOOTH, EVEN AND FREE FROM DEFECTS PER OBC 9.8.9.6.(4)

- STAIRS AND RAMPS SHALL HAVE A COLOUR CONTRAST OR DISTINCTIVE

VISUAL PATTERN TO DEMARCATE THE LEADING EDGE OF THE TREADS. LANDING AND THE BEGINNING AND END OF A RAMP.

| INTERIOR GUARDS:
| O.B.C. SB-7 & 9.8.8.3. |
|-GUARDS TO BE 3'-6" (1070mm) HIGH |
|-FOR DWELLING UNITS GUARDS TO BE A MIN. OF 2'-11" (900mm) HIGH |
|-INCLUDES WINDOWS OVER STAIRS, RAMPS AND LANDINGS |
|-PICKETS TO HAVE 4" (100mm) MAX. SPACING |
|-GUARDS FOR FLIGHTS OF STEPS (EXCEPT EXIT STAIRS) TO BE 2'-11" (900mm) HIGH |

360 EXTERIOR GUARDS:

O.B.C. SB-7 & 9.8.8.3.

-GUARDS ARE REQUIRED WHEN WALKING SURFACE TO GRADE IS GREATER THAN -GUARDS TO BE 3'-6" (1070mm)

-GOARDS (D. 82-86 (100/mm))
-FOR DWELLING UNITS GUARDS TO BE A MIN. OF 2'-11" (900mm) HIGH
-FOR DWELLING UNITS GUARDS TO BE 3'-6" (1070mm) HIGH WHERE WALKING
SURFACE IS MORE THAN 5'-11" (1800mm) ABOVE ADJACENT GRADE.
-PICKETS TO HAVE 4" (100mm) MAX. SPACING
-PROVIDE MID-SPAN POSTS AS PER SB-7.

-GUARDS FOR FLIGHTS OF STEPS (EXCEPT EXIT STAIRS) TO BE 2'-11" (900mm) HIGH

(36b) EXTERIOR GUARDS @ JULIET BALCONY:

-FOR RAILING SPANNING MAXIMUM OF 6'-0". -PROVIDE PREFIN. METAL RAILING W/ $76 \mathrm{mm}$ VERTICAL OPENING TO CONFORM WITH O.B.C. APPENDIX A-9.8.8.5.

-GUARDS TO BE 3'-6" (1070mm) -FOR DWELLING UNITS GUARDS TO BE 2'-11" (900mm) WHERE FLOOR TO GRADE DIFFERENCE IS LESS THAN 5'-11" (1800mm) AS PER O.B.C.

-FOR DWELLING UNITS GUARDS TO BE 3'-6" WHERE FLOOR TO GRADE DIFFERENCE IS 5'-11" (1800mm) OR GREATER AS PER O.B.C. 9.8.8.2. -VERTICAL END RAILING ANCHORED TO CORNER DOUBLE STUDS USING 3

ROWS OF 3/8" $\!\!\!\!/$ MIN. ANCHOR BOLTS EQUALLY SPACED WITH 3" MIN. EMBEDMENT TO STUDS. -PROVIDE SAME ANCHOR BOLTS @ 36" O.C. FOR BASE PLATE CONNECTION.

 $\langle 37
angle$ -linen closet 4 shelves min. 1'-2" (350mm) deep

38) -Washrooms to be mechanically vented to provide at least one alr change per hour, o.b.c.- 9.32.1.3.(3)

(39) -CAPPED DRYER VENT

 $\langle 40 \rangle$ -1"X2" (19mmX38mm) BOTH SIDES OF STEEL.

-WOOD FRAMING MEMBERS SUPPORTED ON CONCRETE IN CONTACT WITH GROUND OR FILL SHALL BE PRESSURE TREATED OR SEPARATED FROM CONCRETE W/ 6 mil POLYETHYLENE.

42 -PRECAST CONC. STEP -2 RISERS MAXIMUM PERMITTED TO BE LAID ON GROUND

SMOKE ALARM, O.B.C. - 9.10.19.
-PROVIDE 1 ON EACH FLOOR INCLUDING BASEMENTS
-PROVIDE 1 IN EACH BEDROOM

-PROVIDE 1 IN EACH BELLWAY SERVICING BEDROOMS
-INSTALLED AT OR NEAR CEILING
-ALARMS TO BE CONNECTED IN CIRCUIT AND INTERCONNECTED SO ALL
ALARMS WILL BE A CTIVATED IF ANY ONE OF THEM SOUNDS AND HAVE A
VISUAL SIGNALLING COMPONENT

-ALARMS MUST BE HARDWIRED AND HAVE AN ALTERNATE POWER SOURCE THAT CAN POWER ALARM FOR 7 DAYS, FOLLOWED BY 4 MINUTES OF ALARM

CARBON MONOXIDE ALARM (CMA), O.B.C.- 9.33.4.
-WHERE THERE IS A FUEL BURNING APPLIANCE A CMA SHALL BE PROVIDED ADJACENT TO EACH SLEEPING AREA.

-CMA TO BE WIRED IN CIRCUIT TO SOUND SMOKE ALARMS WHEN ACTIVATED.

-MAIN DOOR TO BE OPERABLE FROM INSIDE W/OUT KEY -PROVIDE A VIEWER WITH A VIEWING ANGLE OF NOT LESS THAN 160 DEG. UNLESS GLAZING IS PROVIDED IN DOOR OR A SIDELIGHT IS PRESENT. -R4 (RSI 0.70) WHERE A STORM DOOR IS NOT PROVIDED

-GARAGE MAN DOORS TO BE GAS PROOFED WITH SELF CLOSER, WEATHERSTRIPPING, THRESHOLD & DEAD BOLT PER O.B.C. 9.10.13.15. -R4 (RSI 0.70)

-TRAVEL FROM A FLOOR LEVEL TO AN EXIT OR EGRESS DOOR SHALL BE LIMITED TO ONE FLOOR EXCEPT; 1) WHERE THAT FLOOR LEVEL HAS ACCESS TO A BALCONY

2) WHERE THAT FLOOR LEVEL HAS A WINDOW PROVIDING AN UNOBSTRUCTED OPENING OF NOT LESS THAN 3"-3" (1000mm) IN HEIGHT AND 21 5/8" (550mm) IN WIDTH; SUCH WINDOW SHALL BE LOCATED SO THAT THE SILL IS NOT MORE THAN 3"-3" (1000mm) ABOVE FLOOR AND 23"-0" (7.0m) ABOVE ADJACENT GROUND LEVEL.

$\langle 49 \rangle$ EXTERIOR COLUMN W/ MASONRY PIER:

-MIN. 6"X6" (140mm X 140mm) WOOD POST ANCHORED TO PORCH SLAB W/ METAL SADDLE. -TOP PORTION OF POST CLAD W/ DECOR. SURROUND PER ELEVATION

DRAWINGS.
-MASONRY VENEER SURROUND W/ PRECAST CONCRETE CAP. REFER TO

ELEVATION DRAWINGS FOR PIER SIZE AND CAP HEIGHT.
-SURROUND TO BE TIED W/ METAL TIES @ 16" (400mm) O.C. VERT. INSTALLED PER O.B.C. 9.20.9.4. -3/4" AIR SPACE AROUND POST.

OR

-MIN. 6"X6" (140mm X 140mm) WOOD POST CLAD W/ DECOR. SURROUND
(PER ELEVATION DRAWINGS) ANCHORED TO CONC. CAP W/ METAL SADDLE.

-MASONRY PIER TO BE CONSTRUCTED SOLID W/ PRECAST CONCRETE CAP.
REFER TO ELEVATION DRAWINGS FOR PIER SIZE AND CAP HEIGHT.
NOTE: DECORATIVE STRUCTURAL COLUMNS MAY REPLACE 6" X 6" POST
PROVIDED THAT THEY ARE IN CONFORMANCE WITH O.B.C. 9.17.4.

490 EXTERIOR COLUMN:

-MIN. 6'X6" (140mm X 140mm) WOOD POST CLAD W/ DECOR, SURROUND (PER ELEVATION DRAWINGS) ANCHORED TO PORCH SLAB W/ $\,$ METAL SADDLE

NOTE: DECORATIVE STRUCTURAL COLUMNS MAY REPLACE 6" X 6" ABOVE PROVIDED THAT THEY ARE IN ACCORDANCE WITH O.B.C. 9.17.4.

 $\langle 50 \rangle$ COLD CELLARS:

FOR COLD CELLARS PROVIDE THE FOLLOWING:

-VENTING AREA TO BE EQUIVALENT TO 0.2% OF COLD CELLAR AREA. -COVER VENT W/ BUG SCREEN -WALL MOUNTED LIGHT FIXTURE

-L1+L7 FOR DOOR OPENING -2'-8" X 6'-8" EXTERIOR TYPE DOOR (MIN.R-4 RSI 0.7) -INSULATE FULL HEIGHT OF INTERIOR BASEMENT WALL W/ R20 (RSI 3.52)
CONTINUOUS INSULATION (ZONE 1 OBC SB-12 T.3.1.1.2.A.)
- ALTERNATE INSULATION METHOD: 2" (51mm) R10 (RSI 1.76)RIGID INSULATION
W/ 2"A" (38mm X 89mm) WOOD STUD W/ R12 (RSI 2.11) BATT INSULATION

STUD WALL REINFORCEMENT: O.B.C. 9.5.2.3.

-WALL STUDS ADJACENT TO WATER CLOSETS & SHOWER BATH TUBS IN MAIN BATHROOM ARE TO BE REINFORCED TO PERMIT THE FUTURE INSTALLATION OF GRAB BARS AS PER O.B.C. 3.8.3.8.(3)(a)&(e) & 3.8.3.13.(2)(f) & 3.8.3.13.(4)(c)
-GRAB BARS TO BE INSTALLED AS PER O.B.C. 9.8.7.7.(2)

$\langle 53 \rangle$ WINDOW GUARDS:

@ STAIRS, LANDINGS & RAMPS - OBC 9.8.8.1.(8)
WINDOW SILL AT 3-0" (900mm) OR GREATER DOES NOT REQUIRE GUARDS
@ FLOORS - OBC 9.8.8.1.(6)
WINDOWS LESS THAN 1'-7" (480mm) ABOVE FLOORS WHERE ADJACENT GRADE GPEATER THAN 5'-11" (1800r

WINDOW TO BE NON-OPERABLE AND DESIGNED TO WITHSTAND LATERAL LOADS

Ayr

IHESE DRAWINGS ARE OTTO BE SCALED. ALL DIMENSIONS MUST BE VERIFIED BY CONTRACT R PRIOR TO COMMENCEMENT OF ANY WORK UST BE REPORTED DIRECTLY TO RN DESIGN LTD

OFESSION

RN design Imagine - Inspire - Crea

40-03 project # 3/16" = 1'0" 17052 page

, JORGE MORENO DECLARE THAT I HAVE REVIEWED AND TAKEN DESIGN RESPONSIBILITY FOR THE DESIGN WORK ON BEHALF OF RN DESIGN LTD. UNDER DIVISION C, PART-3 SUBSECTION-3.2.4 OF THE BUILDING CODE. I AM QUALIFIED AND THE FIRM IS REGISTERED IN THE APPROPRIATE CLASSES / CATEGORIES.

File:C:\ RN Standards\temp\AcPublish 81736\17052-40-03-FINAL.dwg Plotted: Oct 18, 2019 By:e

QUALIFIED DESIGNER BCIN: FIRM BCIN:

SIGNATURE:

26995

date dwn chk revisions date dwn chk REVISED PER TRUSS COORDINATION REVISED PER ENGINEER COMMENTS & ISSUED FOR PERMIT 23-APR-18 LO JM 20-JUL-18 WU JM 18-Oc1-19 ES ES

Tice River Homes project Legacy

marketing name

FRAME CONSTRUCTION:

- -ALL FRAMING LUMBER TO BE NO. 1 AND No. 2 SPF UNLESS NOTED OTHERWISE.
- ROOF LOADING IS BASED ON 1.5kPa SPECIFIED COMPOSITE SNOW AND RAIN LOADS.

- RAIN LOADS.

 -JOISTS TO HAVE MIN. 1-1/2" (38mm) END BEARING

 -BEAMS TO HAVE MIN. 3-1/2" (89mm) END BEARING

 -DOUBLE STUDS @ OPENINGS

 -DOUBLE HEADER JOISTS AROUND FLOOR OPENINGS WHEN THEY ARE BETWEEN 3'-11" (1200mm) AND 10'-6" (3200mm)
 -DOUBLE TRIMMER JOISTS WHEN HEADER JOIST LENGTH IS BETWEEN 2'-7" (800mm) AND 6'-7" (2000mm)
- -DOUBLE JOISTS OR SOLID BLOCKING UNDER NON-LOAD BEARING PARALLEL PARTITIONS
- -BEAMS TO BE PLACED UNDER LOADBEARING WALLS WHEN WALLS ARE
- -BEAMS MAY BE A MAX. 24" (600mm) FROM LOADBEARING WALLS
- WHEN WALLS ARE PERPENDICULAR TO FLOOR JOISTS

 -APPROVED METAL HANGERS TO BE USED FOR JOISTS AND BEAMS WHEN
 THEY FRAME INTO SIDES OF BEAMS, TRIMMERS AND HEADERS

 -FLOOR JOISTS SUPPORTING ROOF LOADS SHALL NOT BE CANTILEVERED MORE THAN 15 3/4" (400mm) BEYOND SUPPORTS FOR 2" X 8" (38mm X
- -FLOOR JOISTS SUPPORTING ROOF LOADS SHALL NOT BE CANTILEVERED. MORE THAN 23 5/8" (600mm) BEYOND SUPPORTS FOR 2" X 10" (38mm X 235mm) OR LARGER.

WATERPROOF WALLS IN BATHROOMS:

-REQUIRED AS PER OBC 9.29.2.1.

WINDOWS:

- -WINDOWS TO BE SEALED TO THE AIR & VAPOR BARRIER
 -WINDOWS THAT SEPARATE HEATED SPACE FROM UNHEATED SPACE SHALL
 HAVE AN OVERALL COEFFICIENT OF HEAT TRANSFER OF
- 1.6 W/(m2.K) OR

 -AN ENERGY RATING OF NOT LESS THAN 25 FOR WINDOWS

 -BASEMENT WINDOWS WITH LOAD BEARING STRUCTURAL FRAME SHALL
 BE DOUBLE GLAZED WITH LOW-E COATING

 -SKYLIGHTS SHALL HAVE AN OVERALL COEFFICIENT OF HEAT TRANSFER OF
- -FOR GROSS GLAZED AREAS LESS THAN AND EQUAL TO 17%

DRAIN WATER HEAT RECOVERY:

♦ CLIENT SPECIFIC REVISIONS

FIRM BCIN:


SIGNATURE:

DATE:

- DWHR UNITS TO BE INSTALLED AS PER OBC SB-12 3.1.1.1.(22) & 3.1.1.12.
- SENTENCES (1) TO (6)

 DWHR ARE REQUIRED IN ALL DWELLING UNITS TO RECEIVE DRAIN WATER FROM ALL SHOWERS OR FROM AT LEAST 2 SHOWERS WHERE THERE ARE 2 OR MORE SHOWERS PROVIDED THERE IS A CRAWL SPACE OR STOREY BELOW THE SHOWERS.

NEITHER THE GRANTING OF A PERMIT NOR THE APPROVAL OF SPECS & DRAWINGS NOR INSPECTIONS MADE BY THE OFFICIAL HAVING JURISDICTION SHALL RELIEVE THE OWNER FROM REQUIREMENTS OF THE ONTARIO BUILDING CODE AND ANY OTHER REFERENCED REQUIREMENTS.

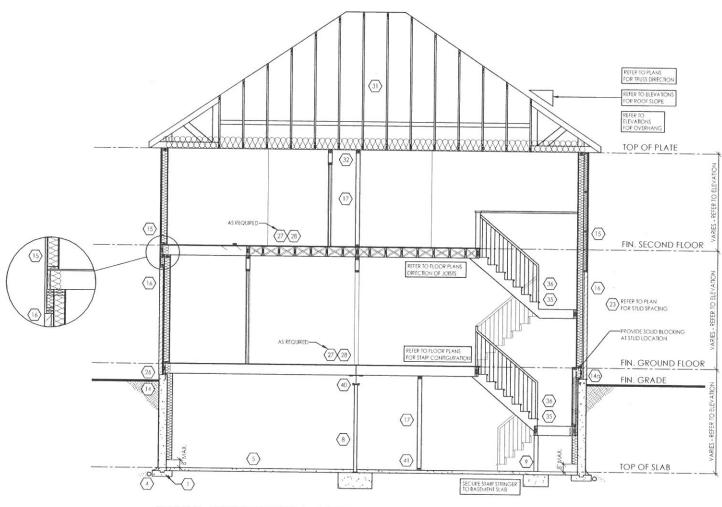

TYPICAL CROSS SECTION - 2 STOREY (SIDING & BRICK)

N.T.S.


2 REVISED PER TRUSS COORDINATION
3 REVISED PER ENGINEER COMMENTS & ISSUED FOR PERMIT

5 RE-ISSUE FOR PERMIT

26995

DRAWINGS ARE NOT TO BE SCALED. ALL DIMENSIONS MUST BE VERIFIED BY CONTRACTOR PRIOR TO COMMENCEMENT OF ANY WORK ANY DISCREPANCIES MUST BE REPORTED DIRECTLY TO RN DESIGN LTD

page

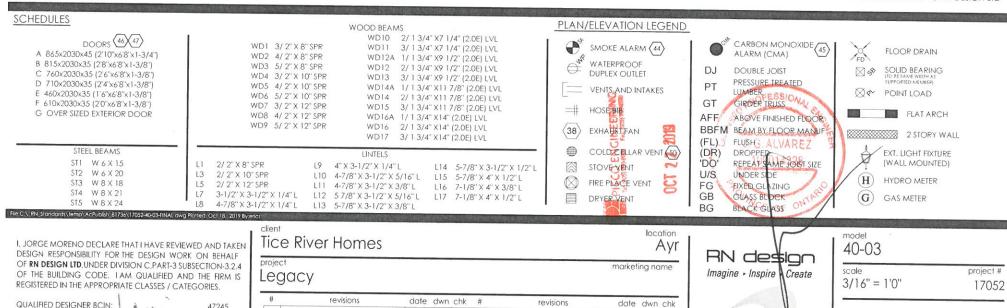

23-APR-18 LO JM

18-Oct-19 ES ES

JM

20-JUL-18 WU