IT IS THE CONTRACTOR'S RESPONSIBILITY TO ENSURE THAT ALL CONSTRUCTION CONFORMS TO THE REQUIREMENTS OF THE ONTARIO BUILDING CODE. NOTATIONS MADE ON THESE DRAWINGS ARE FOR YOUR INFORMATION AND ASSISTANCE ONLY AND DO NOT NECESSARILY COMMENT ON ALL AREAS OF CONSTRUCTION

APPROVED DRAWINGS HAVE BEEN RED LINED INDICATING A CHANGE TO MEET THE OBC. PLEASE REVIEW ALL PAGES TO ENSURE YOU ARE PROPERLY INFORMED OF CHANGES.

TIGHTLY FIT ELECTRICAL BOXES WHERE BOXES ARE LOCATED ON BOTH SIDES OF WALL PROVIDING A F.R.R., OFFSET BOXES AT LEAST ONE STD SPACE TO MAINTAIN INTEGRITY OF FIRE SEPARATION.

CALL FOR INSPECTION OF EXCAVATION CRIBBING BEFORE POURING ANY CONCRETE

ANY MODIFICATIONS TO GRADING SHALL NOT ADVERSELY AFFECT **NEIGHBORING PROPERTIES**

INAL GRADING CERTIFICATE REQUIRED BEFORE FINAL **INSPECTION SIGN-OFF**



FRONT ELEVATION ELEV 'A' (LEFT)

FRONT ELEVATION ELEV 'A' (RIGHT)

ADUB

FRONT ELEVATION ELEV 'B' (LEFT)

FRONT ELEVATION ELEV 'B' (RIGHT)

NEITHER THE GRANTING OF A PERMIT NOR THE APPROVAL OF SPECS & DRAWINGS NOR INSPECTIONS MADE BY THE OFFICIAL HAVING JURISDICTION SHALL RELIEVE THE OWNER FROM REQUIREMENTS OF THE ONTARIO BUILDING CODE AND ANY OTHER REFERENCED REQUIREMENTS.

INSPECTIONS ARE REQUIRED TO BE EMAILED IN TO BUILDING@NORTHDUMFRIES.CA 24 HOURS IN ADVANCE OF THE REQUIRED INSPCTION.

Drawing List:

- A0 TITLE SHEET
- A1 BASEMENT FLOOR PLAN ELEV. 'A' & 'B'(RIGHT) BASMENT FLOOR PLAN ELEV. 'A' & 'B'(LEFT)
- A2 GROUND FLOOR PLAN ELEV. 'A' (RIGHT) GROUND FLOOR PLAN ELEV. 'A' (LEFT)
- A3 SECOND FLOOR PLAN ELEV. 'A' (RIGHT) SECOND FLOOR PLAN ELEV. 'A' (LEFT)
- A4 GROUND FLOOR PLAN ELEV. 'B' (LEFT) GROUND FLOOR PLAN ELEV. 'B' (RIGHT)
- A5 SECOND FLOOR PLAN ELEV. 'B' (RIGHT) SECOND FLOOR PLAN ELEV. 'B' (LEFT)
- ROOF PLAN ELEV 'A' Α6 FRONT ELEVATION ELEV 'A' (LEFT) FRONT ELEVATION ELEV 'A' (RIGHT)
- **A**7 RIGHT SIDE ELEVATION 'A'
- Α8 REAR ELEVATION 'A' & 'B' REAR ELEVATION 'A' & 'B'
- A9 LEFT SIDE ELEVATION 'A'
- A10 ROOF PLAN ELEV 'B'
 - FRONT ELEVATION ELEV 'B' (LEFT) FRONT ELEVATION ELEV 'B' (RIGHT)
- RIGHT SIDE ELEVATION 'B' A11
- A12 LEFT SIDE ELEVATION 'B'
- D1 CONSTRUCTION NOTES
- D2 CONSTRUCTION NOTES

CONSTRUCTION NOTES

Areas:

	ELEVATION 'A' (LEFT)		ELEVATION 'A' (RIGHT)		ELEVATION 'B' (LEFT)		ELEVATION 'B' (RIGHT)	
	SF	SM	SF	SM	SF	SM	SF	SM
GROUND FLOOR PLAN	826.1	76.7	826.1	76.7	826.1	76.7	826.1	76.7
SECOND FLOOR PLAN	1041.0	96.7	1053.3	97.9	1041.0	96.7	1058.6	98.3
TOTAL AREA	1867.1	173.5	1879.4	174.6	1867.1	173.5	1884.7	175.1
COVERAGE INC PORCH	1186.5	110.2	1186.5	110.2	1186.5	110.2	1186.5	110.2
COVERAGE NOT INC PORCH	1089.6	101.2	1089.6	101.2	1089.6	101.2	1089.6	101.2



TOWNSHIP OF NORTH DUMFRIES BUILDING DEPARTMENT

These Plans have been examined for Compliance with the Ontario Building Code requirements. A Building Permit has been Issued, subject to any changes noted, under the condition that the building will be constructed in accordance with the code.

Adam Miller

12/17/2020

REVIEWED BY

DATE

Tice River Homes

Legacy

THE FLOOR AND TRUSS LAYOUTS PROVIDED BY THE MANUFACTURER HAVE BEEN REVIEWED, APPROVED AND COORDINATED ON THE WORKING DRAWING PLANS PROVIDED BY RN DESIGN

Tice River Homes

Legacy

revisions



marketing name

date dwn chk



Ayr







page

project # 17052

ISSUED FOR CLIENT REVIEW 23-FEB-18 ES ES 5 RE-ISSUED FOR PERMIT 18-Oct-19 ES ES REVISED PER TRUSS COORDINATION 20-JUL-18 LO JM REVISED PER ENGINEER COMMENTS & 20-JUL-18 WU JM SSUED FOR PERMIT MADE ALL PARTIAL PLANS INTO FULL 4-0c1-19 KC ES PLANS PER CITY COMMENTS

date dwn chk #

REGISTERED IN THE APPROPRIATE CLASSES / CATEGORIES QUALIFIED DESIGNER BCIN: FIRM BCIN: DATE:


D3


I, JORGE MORENO DECLARE THAT I HAVE REVIEWED AND TAKEN


DESIGN RESPONSIBILITY FOR THE DESIGN WORK ON BEHALF OF RN DESIGN LTD, UNDER DIVISION C, PART-3 SUBSECTION-3.2.4


OF THE BUILDING CODE. I AM QUALIFIED AND THE FIRM IS


SIGNATURE

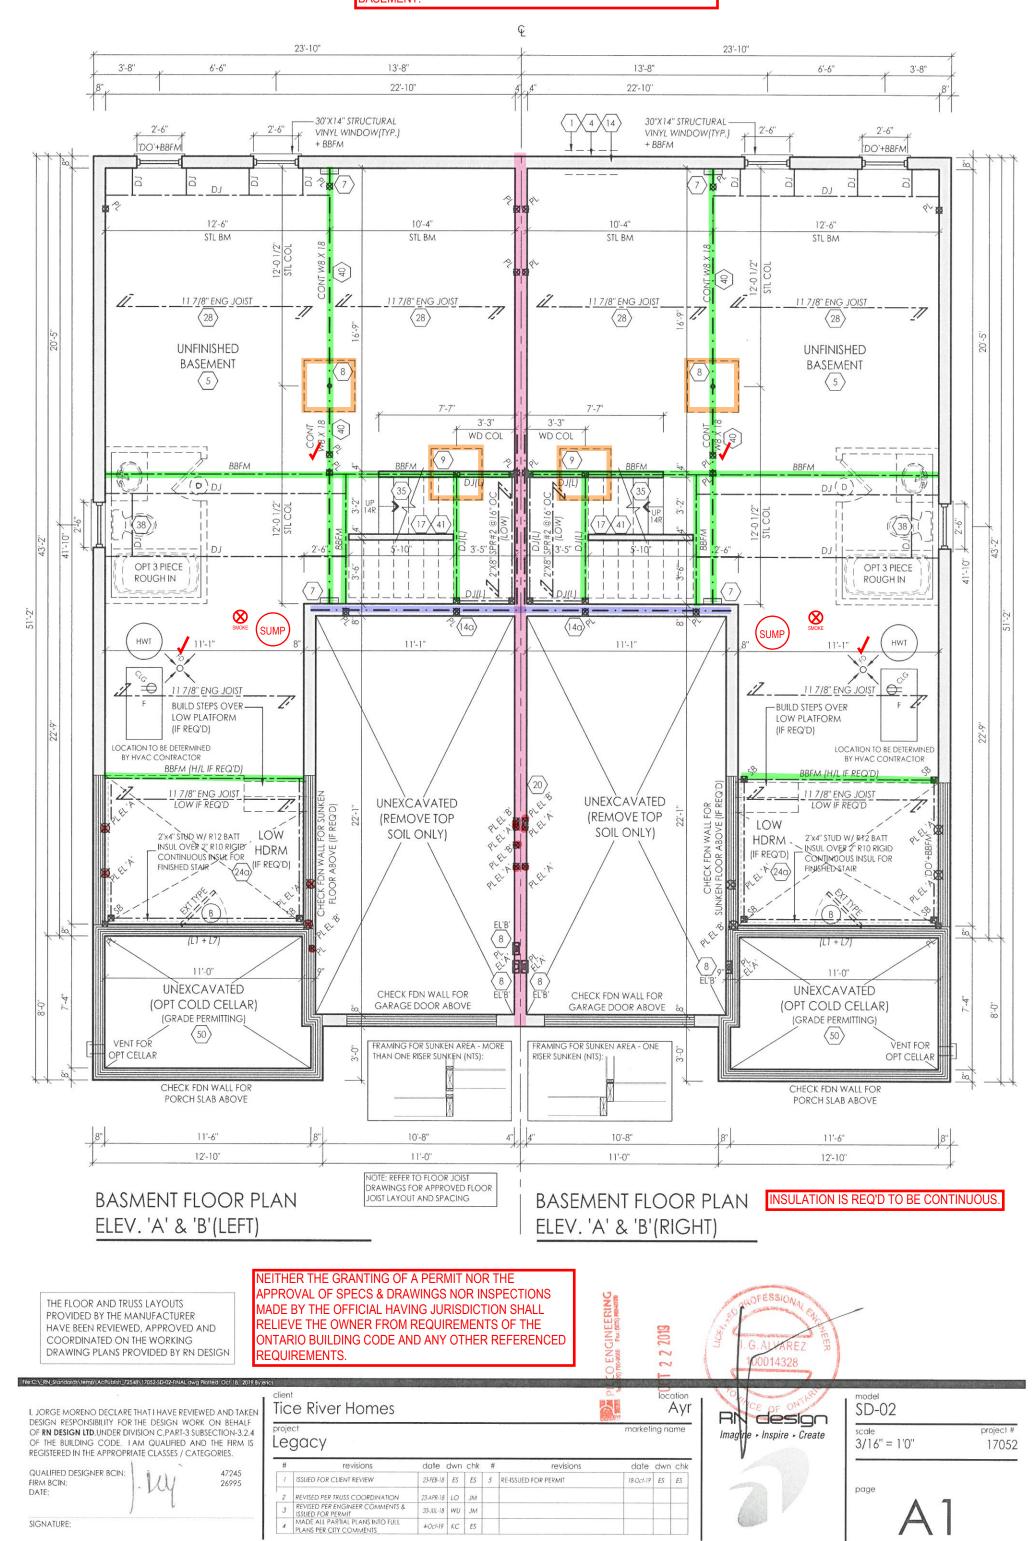


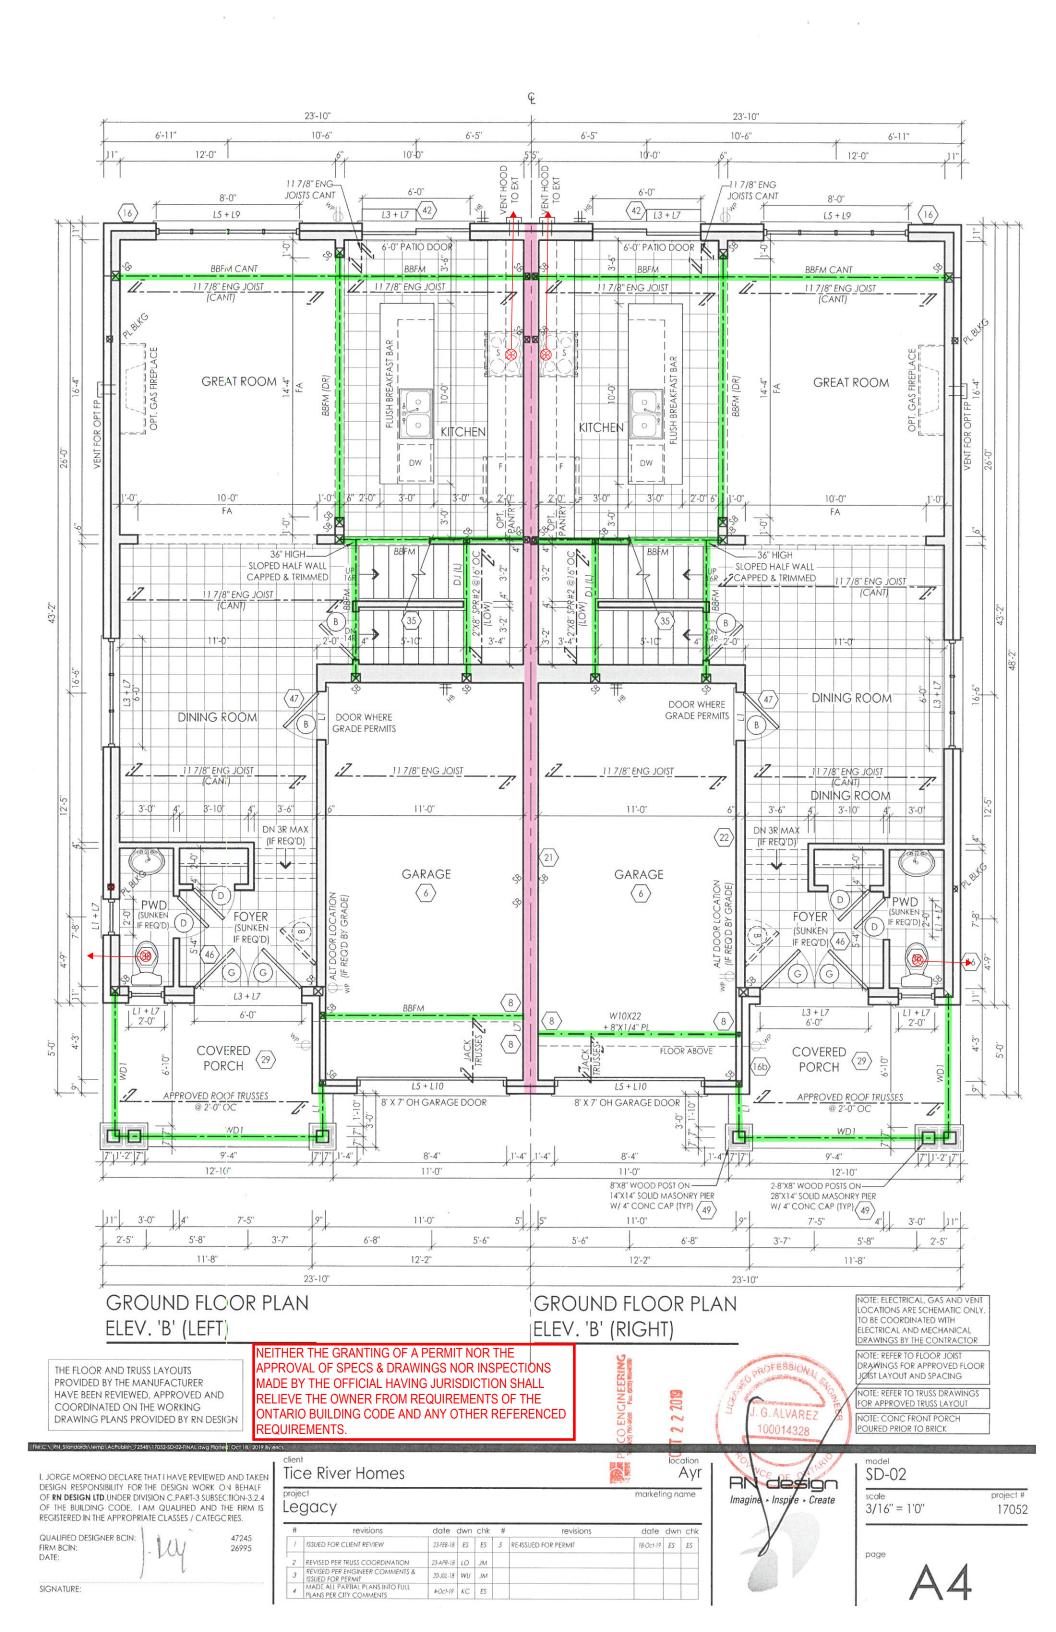


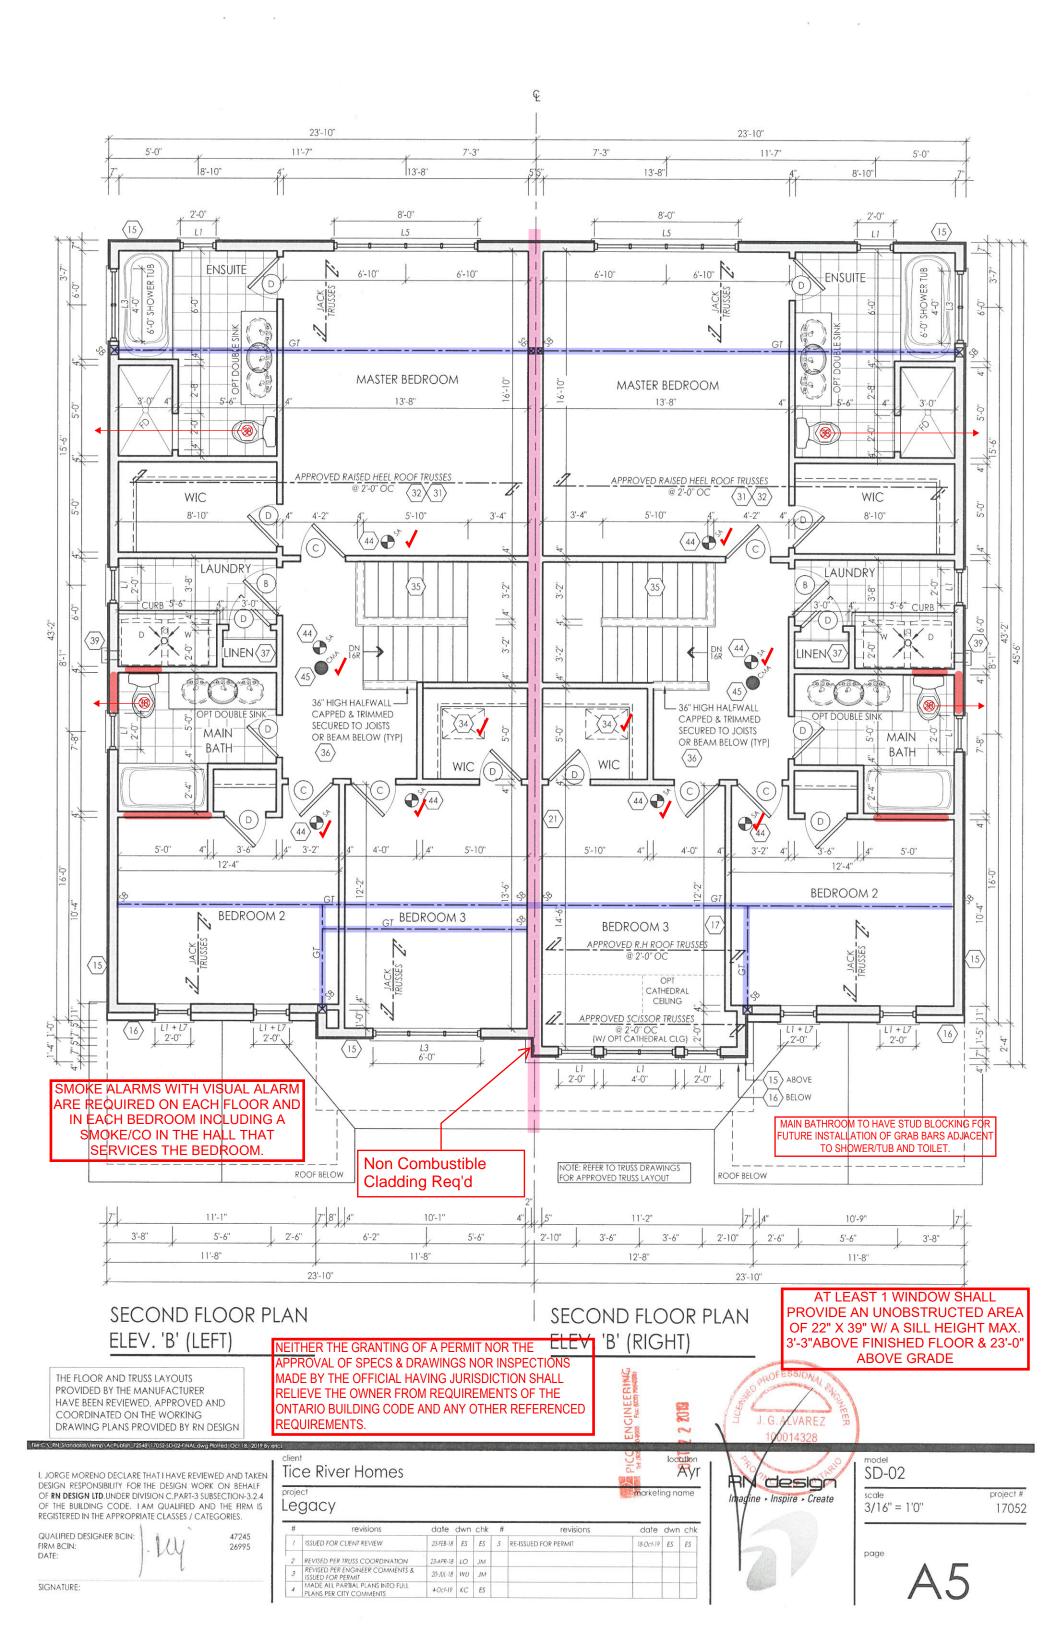

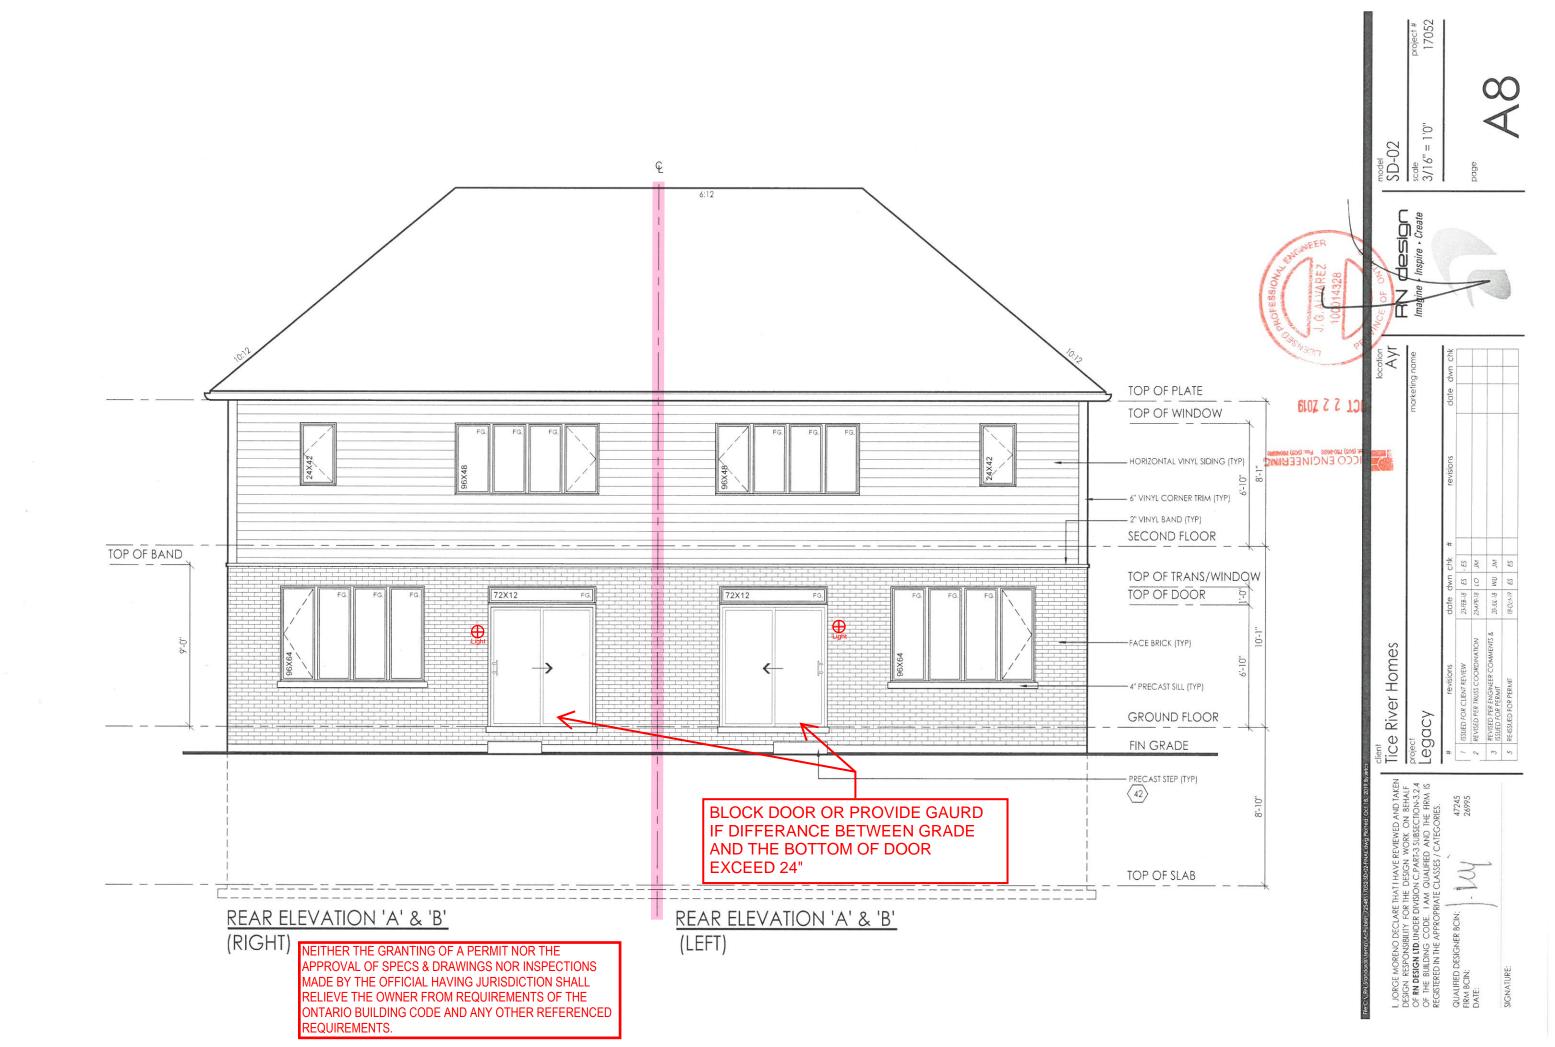

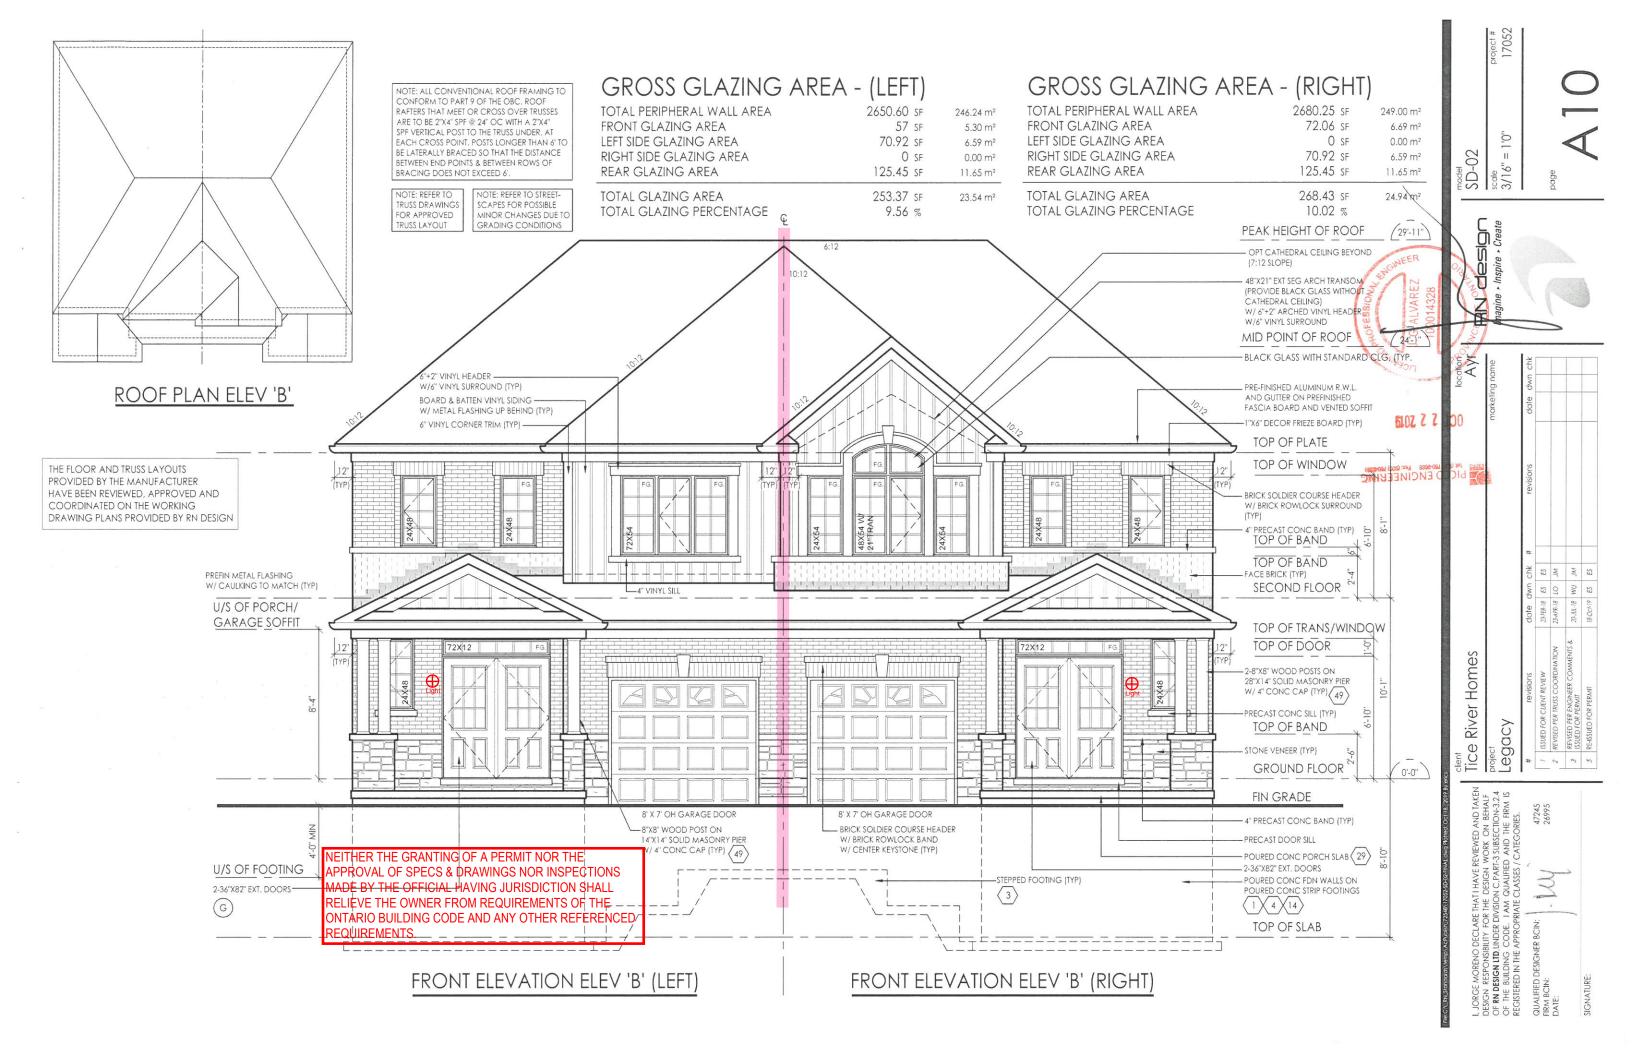

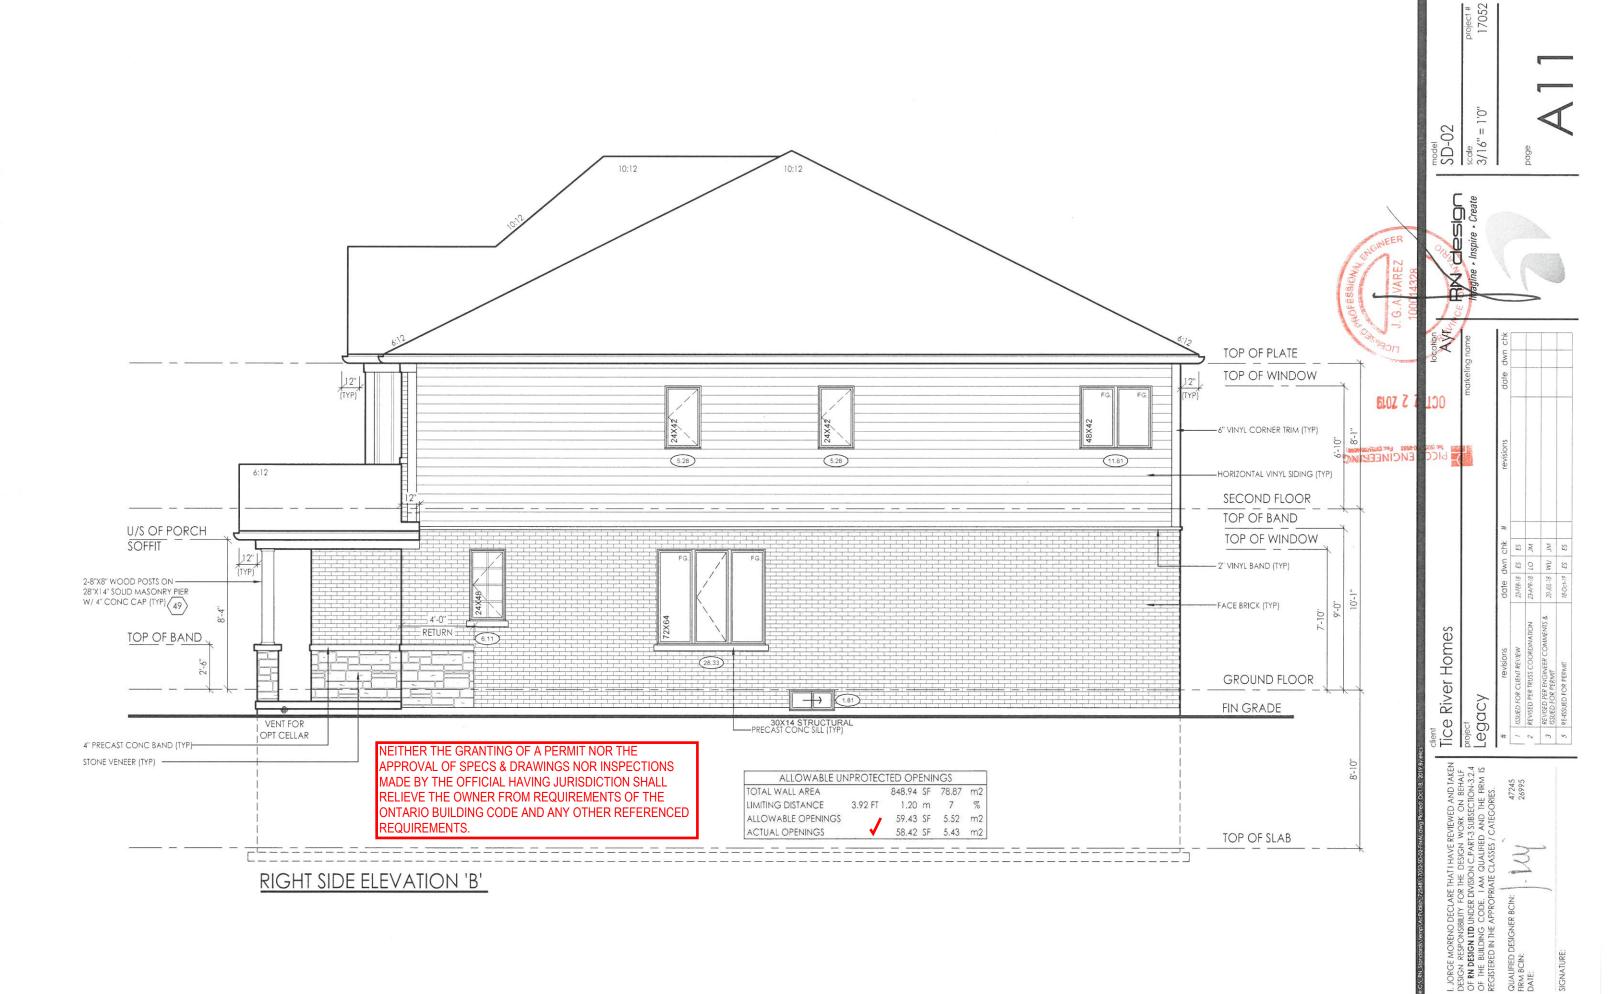

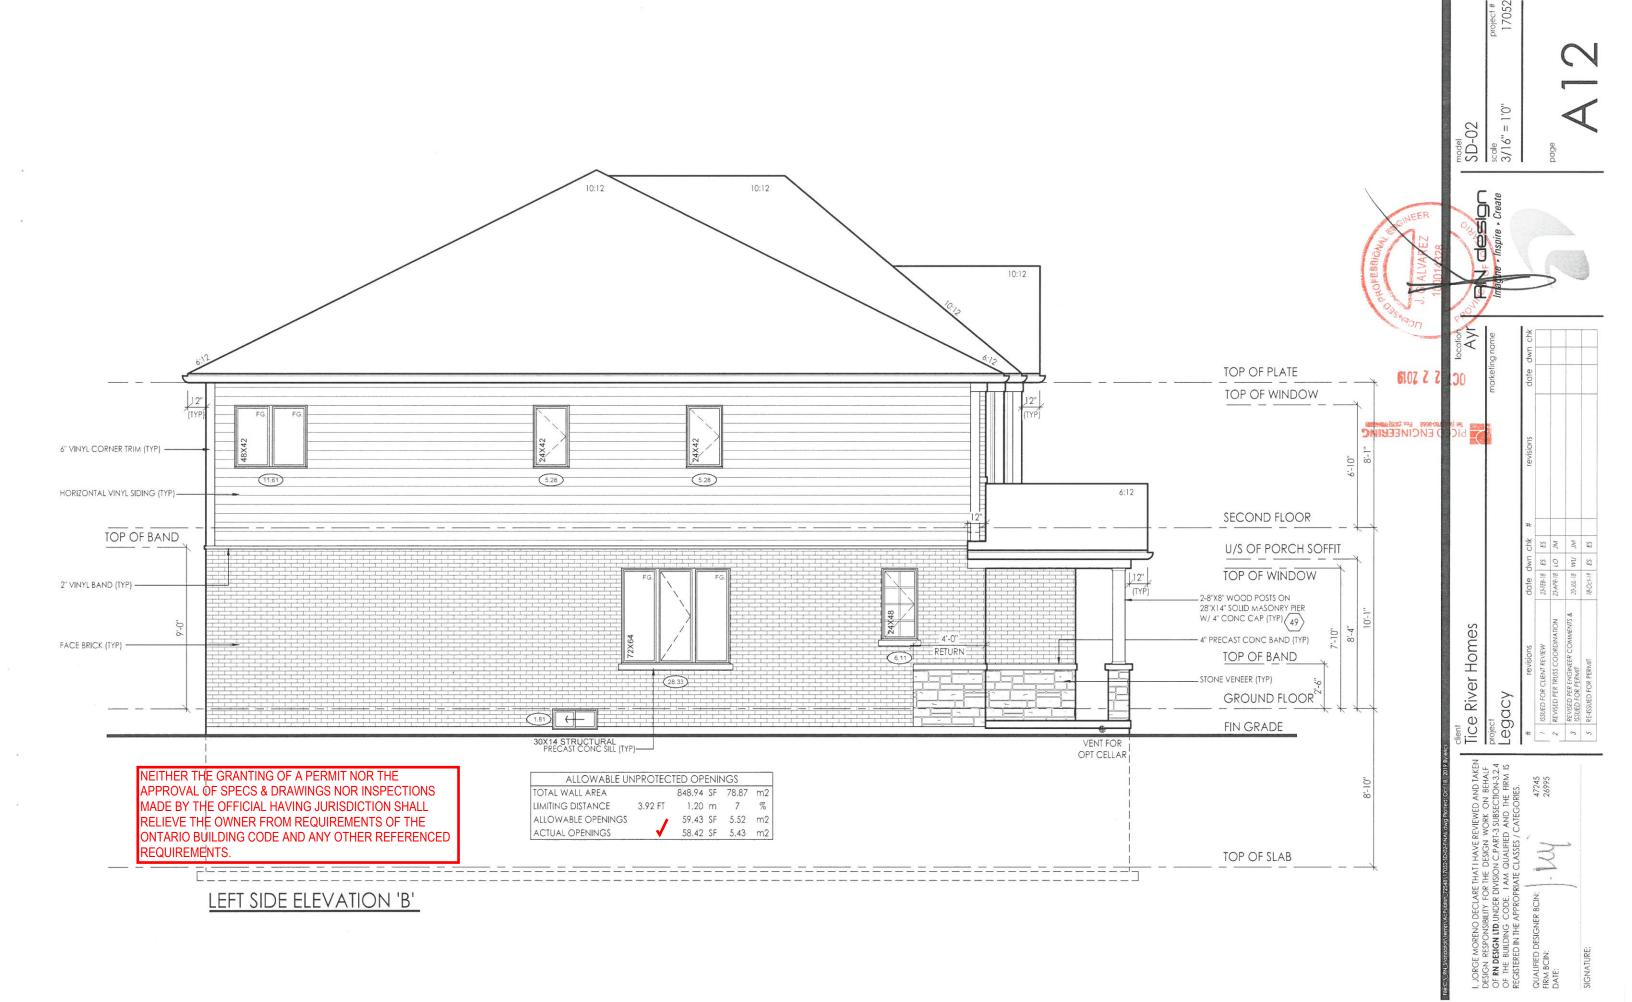

CONSTRUCTION NOTES: - TOWNS & SEMIS COMPLIANCE PACKAGE A1 - OBC 2012 - 2017 ENACTMENT

FOOTINGS / SLABS: TYPICAL STRIP FOOTING:

4-16. SULES MAY BE REDUCED FOR SOILS W/ GREATER BEARING CAPACITY (AS PER SOILS ENGINERING REPORT)
-REFER TO WORKING DRAWINGS FOR SPECIFIC SIZES THAT MAY SUPERSEDE NOTES #1 8, #2 FOR FOOTING SIZES.

TYPICAL STRIP FOOTING: (EXTERIOR WALLS) **E**

-1 STOREY - 10" X 4" -2 STOREY - 14" X 4" -3 STOREY - 18" X 5"

2 TYPICAL STRIP FOOTING: (INTERIOR BEARING WALLS)

O.B.C. 9.15.3.4

(3) STEP FOOTING:

9.15.3.9. mm) MAX. VERTICAL RISE & 23 5/8"

DRAINAGE TILE OR PIPE: 4

(2)

9-13. & 9.16.
CONCRETE SIAB
APOJ AFIER 28 DAYS - O.B.C. 9.16.4.5.
APOJ AFIER 28 DAYS - O.B.C. 9.16.4.5.
ROOFING W/ 4" (100mm) LAPPED JOINTS.
FING MAY BE CONITED IF CONCRETE HAS MIN. 3600psi(25MPa)
FESTENCIH AFIER 28 DAYS
OF COURSE GRANULAR MATERIAL
NID BREAKING MATERIAL BETWEEN SIAB & FIG.
NID BREAKING MATERIAL BETWEEN SIAB & FIG.

R O.B.C.9.31.4.4.

JUATION AT PERMETER OF SLAB WHERE GRADE IS WITHIN SASSEMENT SLAB EDGE. INSULATION TO EXTEND TO NOT (600mm) BELOW EXTERIOR GRADE LEVEL (OBC SB-112-

lan Be demonstrated that soil Gas does not constitute Soil Gas control Shall Conform to Supplementary O.B.C. SB-9)

(50)

AFTER 28 DAYS

UNDER ENTRES SLAB WHERE THE ENTRE SLAB IS
F CRADE (OBC SB-12 3.1.1.7.(6))
GRANULAR MATERIAL
G MATERIAL BETWEEN SLAB 8. FIG.
10 BE WATERPROOFED IT SHALL CONFORM TO

i per O.B.C.9.31.4.4. n be demonstrated that soil gas does not constitu oil gas control shall conform to supplementary

(6) GARAGE SLAB / EXTERIOR SLAB: -4"(100mm) CONCRETE SLAB

7) <u>PILASTERS:</u>
O.B.C. 9.15.5.3.
PILASTER
-CONCRETE NIB - 4"X 12" (100mm X 300mm)
-BLOCK NIB - 4"X 12" (100mm X 300mm)
-BLOCK NIB - 4"X 12" (100mm X 300mm)
-BLOCK NIB - 4"X 12" (100mm X 300mm)
-CONCRETE NIB - 4"X 12" (100mm X 300mm) FDN. WALL W/ WIDTH TO MATCH BEAM SIZE.
CE AROUND WOOD BEAMS (O.B.C. 9.23.2.2.)
OLUMNS

(8) STEEL PIPE COLUMN:
O.B.C. 9.15.3.4. 8.9.17.3.

-FIXED COLUMN.

-AINI, 3 1/2' (90mm) DIA, W/3/16" (4.76mm) WALL THICKNESS

-FOR STEEL BEAMS, CLIPS @ 10P 8 MIN. 6" X 4" X 1/4" (152mmX 100mm)

-FOR WOOD BEAMS, MIN. 4" X4" X 1/4" (100mmX 100mm X 6.35mm) STEE

-FOR WOOD BEAMS, MIN. 4" X4" X 1/4" (100mmX 100mm X 6.35mm) STEE

-FOR WOOD BEAMS, MIN. 4" X4" X 1/4" (100mmX 100mm X 6.35mm) STEE

-FOR WOOD BEAMS, MIN. 4" X4" X 1/4" (100mmX 100mm X 6.35mm) STEE

-FOR WOOD BEAMS, MIN. 4" X4" X 1/4" (100mm X 6.35mm)

- ADJUSTABLE COLUMNS TO CONFORM TO CANI/CGSB-7.2-M WHERE

IMPOSED LOAD DOES NOT EXCEED 36 KN (O.B.C. 9.17.3.4.)

- STOREY

- AN X 34" X 16"

- 34" X 34" X 18" - [860mmX 860nmX 400mm] - 44" X 44" X 21" - [1120mmX 1120mmX 530mm] 3 STOREY -MAX. 9'-10" (2997mn .MAX. 16'-0" (4880n

-40" X 40" X 19"
-40" X 40" X 19"
- (1010mmX 1010mmX 480m
-451" X 24"
- 1295mmX 1295mmX 610m
-WHERE COL. SITS ON FDN. WALL. USE 4" X 8" X 5/8" (100mmX 16mm) SIEEL PLATE WITH 2-5/8" (16mm) ANCHOR BOLTS

(9) WOOD COLUMN:

1) SOLID WOOD COLUMN - OR TUP COLUMN NALED TOGETHER W/ 3" (76mm) N 12" (330mm) APART OR BOLTED TOGETHER W/ BD 118" (450mm) O.C.

WALL ASSEMBLIES: (14) FOUNDATION WALL:

-MAX. UNSUPPORTED HEIGHT OF 3-11" (1200mm) & MAX. SUPPORTED HEIGHT OF 7-0" (2150mm) MEASURED FROM GRADE TO FINISHED BASEMENT FLOOR.

22 ST.O" (2150mm) MEASURED FROM GRADE TO FINISHED BASEMENT FLOOR.

23 ST.O.-EG ROWNED NOT FROM CHAPTER TO THE TO T

HAN B (200mm) ABOVE HNISHED FLOOK OF F12.1.1.2.A.) DD STUD W/R12 (RSI 2.11) BATT INSULATION SUSCEPTIBLE SOIL

THE FOUNDATION WALL IS REDUCED IN THICKNESS TO "ACING, THE MIN. REDUCED THICKNESS SHALL NOT BE LESS THICK.

ITH METAL THES SPACED MAX. @ 7.7/8" (200mm) JOHNN) HORIZONTALLY. WHO FACING SOLID WI MORTAR 2R JOSIS, THE REDUCED THICKNESS SHALL BE 8. MIN. 3-1/2" (90mm) THICK USULATION EXTENDS TO MORE THAN 2-11" (900mm) BELOW GRADE ALL DRAINAGE LAYER SHALL BE PROVIDED IN CONFORMANCE TO 14.2.1.(2) (3) (4)
BASEMANIS SHALL HAVE INTERPORT. ALL HAVE INTERIOR DAMPPROOFING EXTENDING EVEL & SHALL CONFORM TO O.B.C. 9,13.2.6.(2)(b) PESSURE OCCURS, FDN. WALLS SHALL BE O.B.C. 9,13.3. ROOFING & WATERPROOFING: SROOF THE EXTERIOR FACE OF WALL BELOW GRADE AS PER O.B.C. .C. 9.13.3. OFED DO NOT REQUIRE DAMPPROOFING.

(40)

(15)

VATIONS, MIN. 7 7/8" (200n

9.27,1
ANE AS PER O.B.C. 9.27.3.2.
ANE FOR TYPE J OR EGUIVALENT AS PER O.B.C. 9.23.16.
WOOD STUDS @ 16" (400mm) O.C.
ATION (ZONE 1. OBC SB-12.1.3.2.A.)
JR BARRIER IN CONFORMANCE W/ O.B.C. 9.25.3. 8.9.25.4..

R22 (RSI 3.87) INSULATION WITH R22 (RSI 3.87) ABSORPTIVE 3. MATERIAL WITH A MASS OF AT LEAST 4.8 kg/ sq.m. 1/12" (12.7mm) INTERIOR GYPSUM BOARD WITH 1/2" (12.77 8.0.AD

. FOR FIRE RATING (LESS THAN 2-0" LIMITING DISTANCE):
TO REQUIREMENTS FOR LESS THAN 4-0" LIMITING DISTANCE AND
FEPACE THE POLLOWING:
COMBUSTABLE SIDING OR STUCCO AS PER ELEVATIONS (REFER TO
"ACTURERS SPECIFICATIONS):

-vinyl siding is permitted per O.B.C. 9.10.15.5(3). Over 1/2" (12.7mm) Gypsum exterior sheathing which replaces. Exterior Plywood or

(15b) FRAME WALL CONSTRUCTION @ GARAGE:

CO AS PER ELEVATIONS, MIN. / 1/16. (200min) traum O.B.C. 9.28.1.4. & 9.27.) 6. MEMBRANE AS PER O.B.C. 9.27.3.2. COD (EXTERIOR TYPE) OR EQUIVALENT AS PER O.B.C.

STUDS @ 16" (400mm) O.C.

nx 89mm) WOOD STUDS @ 16" (400mm) O.C.

I) GYFSUM BOARD

PPORT FOR 2 +3 FLOORS ABOVE - O.B.C. 1,9.23.10.1. =

RS SUPPORTED A BOVE, 2" x 4" (38mmx 89mm) STUDS ARE

BE SPACED @ 12" (300mm) O.C.

RS SUPPORTED ABOVE, 2" x 6" (38mmx 140mm) STUDS ARE

BE SPACED @ 12" (300mm) O.C.

WITH A MASS OF AT LEAST 2.8 kg/ sq.m. SUM BD. W/ 1/2" (12.7mm) TYPE X" GYPSUM BD. SS THAN 2"-O" LIMITING DISTANCE]:

LESS THAN 4'-0" LIMITING DISTANCE AND

PER O.B.C. 9,10,15,5,(3). OVER SHEATHING GYPSUM EXTERIOR SHEATHING WHICH REPLACES

16) BRICK VENEER CONSTRUCTION: O.B.C. 9.23.

FACE BRICK OR 4" (100mm) STONE @ 36'-1" (11m) MAX. . 0.03" (0.76mm), THICK, 7/8" (22mm), WIDE CORROSION RESISTANT PS, @ MAX., 15.3/4" (400mm), O.C., HORIZONTAL & 23.5/8" (600mm) ICAL SPACING.

" (38mmX 140mm) WOOD STUDS ® 16" (400mm) O.C. 822 [RSI 3.67] INSULATION (20NE 1. OBC SB-12 T.3.1.1.2.A.) IINUOUS AIR/VAPOUR BARRIER IN CONFORMANCE W/ O.B.C.- 9.25.3 ENINGS ASE FLASHING UP TO 57/8" (150mm) BEHIND WALL SHEATHING ASEAN (10.8.C., 9.20.13.6.(2)) HICK OR STONE SILLS UNDER OPENINGS, FLASHING UNDER (25mm) ARS PACE 12. SHEATHING MEMBRANE AS PER O.B.C., 9.27.3.2. 4" (6mm) PLYWOOD (EXTERIOR TYPE) OR EQUIVALENT AS PER O.B.C.

8 9.25.4, -1/2" (12.7mm) GYPSUM BOARD NOTE - SUPPORT FOR 3 FLOORS ABOVE - O.B.C. 1.9.23,10,1, = -FOR 3 FLOORS SUPPORTED ABOVE, 2" x 6" (38mmX 140mm) STUDS ARE REQUIRED TO BE SPACED ® 12" (300mm) O.C.

(16b) BRICK VENEER CONSTRUCTION @ GARAGE:

(90mm) FACE BRICK OR 4" (100mm) STONE @ 36'-1" (11m)

HI .0.03" (0.76mm) THICK, 7/8" (22mm) WIDE CORROSION RESISTANT PS @ MAX. 15.314" (400mm) O.C. HORIZONTAL & 23.5/8" (600mm) ICAL SPACING VIDE WEEP HOLES @ 2-7" (800mm) O.C. @ BTM. COURSE & OVER

IING UP TO 57/8" (150mm) BEHIND WALL SHEATHING (O.B.C. 9.20.13.6.(2)) TONE SILIS UNDER OPENINGS, FLASHING UNDER AM SPACE THING MEMBRANE AS PER O.B.C. 9.27.3.2. PLYWOOD (EXTERIOR TYPE) OR EQUIVALENT AS PER O.B.C.

38mmx 89mm) WOOD STUDS @ 16" (400mm) O.C.
2.7mm) GYPSUM BOARD
- SUPPORT FOR 2 + 3 FLOORS ABONE - O.B.C. T.9.23.10.1, =
1.00CRS SUPPORTED ABONE, 2" X 4" (38mmx 89mm) STUDS ARE
ED TO BE SPACED @ 12" (300mm) O.C.
11.00RS SUPPORTED ABONE, 2" X 6" (38mmx 140mm) STUDS ARE
ED TO BE SPACED @ 12" (300mm) O.C.

sq.m. -REPLACE 1/2"(12.7mm) GYPSUM BD. W/ 1/2" (12.7mm) TYPE 'X' GYP! L = EW1b (STC = N/A, FIRE = 45 TED WALL REQUIREMENTS SUBST RIALS:

(17) INTERIOR STUD WALLS:

0.8.C. -2" x 4" (38m -2" x 6" (38m

(18) BEARING STUD WALL (BASEMENT):

TUDS @ 16" (400mm) O.C. OR STUDS @ 16" (400mm) O.C. W/

ON DAMPPROOFING MATER 30TH SIDES. LIS @ 7'-10" (2400mm) O.C. = #2 W/4" CONC. CURB

C. 9.10.11. & 3.1.10. & SB-3 WALL = B6e (STC = 57, FIRE = 2 HR)
WALL IS REQUIRED FOR EVERY 6460 S.F. (600 SQ.M) OF BUILDING JM BOARD W/TAPED JOINTS n) WOOD STRAPPING @ 24" (600mm) O.C. ON BO

DJACENT ROOFS IS GREATER UPPER ROOF SURFACE PER

(20) PARTY WALL - FOUNDATION:

UD CONC. FOUNDATION WALL ® 2200psi (15MF NGTH AFTER 28 DAYS I TO REST ON FOOTING PER GENERAL NOTE #^

21) PARTY WALL - WOOD STUD:

WE MATERIAL ON BOTH SIDES FILLING A MINIMUM O L=W13a (STC = 57, FIRE = 1 HR)
NCE RATING CONTINUOUS FROM TOP OF
OF ROOF DFCK m) STUDS @ 16"(400mm) O.C. W/ SEP OM PLATE & SEPARATE DOUBLE 2" X

COUSTICAL SEALANT AS PER O.B.C. SB-3 (NOTE (2) TO TABLE 1)
NOTE - SUPPORT FOR 2 + 3 FLOORS ABOVE - O.B.C. T.9.23.10.1. =
RR 2 FLOORS SUPPORTED ABOVE, 2" X 4" (38mmX 89mm) STUDS ARE
3 JUKED TO BE SPACED @ 12" (300mm) O.C.

F2.V.S. STUDS ARE USED A1 STAR OPENING CONTINUE TO USE ON REMAINING FLOORS AT 1THE STAR OPENING A1 16" O.C.

Tice River Homes

project Legacy

I, JORGE MORENO DECLARE THATI HAVE REVIEWED AND TAKEN DESIGN RESPONSBUITY FOR THE DESIGN WORK ON BEHALF OF RN DESIGN LID, UNDER DIVISION C, PART-3 SUBSECTION-3.2.4 OF THE BUILDING CODE. I AM QUALIHED AND THE HRM IS RECISTERED IN THE APPROPRIATE CLASSES / CATEGORIES.

QUALIFIED DESIGNER BCIN: FIRM BCIN: DATE:

SD-02 scale 3/16" = 1'0"

17052

INSULATION IN WALLS,
INSULATION IN CEILINGS W/FLOOR ABOVE
AIR/VAPOUR BARRIER IN CONFORMANCE W/O.B.C.A FOR FLOOR ABOVE.

REQUIRED GARGE AREA (REFER TO MUNICIPAL STANDARUS).

1/2" (12.7mm) GYPSUM BOARD

-ROOF FRAMING MEMBERS ARE FASTENED TO TOP PLATES WITH

4 - 31 /4" (82mm) TOE NAILS

-BOTTOM PLATES ARE FASTENED TO FLOOR JOISTS, BLOCKING OR

RIM JOIST WITH 3 1/4" (82mm) NAILS AT 7 /8" (200mm) O.C.

WALLS ADJACENT TO ATTIC SPACE:

1/2" (12.7mm) GYPSUM BOARD

AIR/VAPOUR BARRIER IN CONFORMANCE W/ O.B.C.-

'LYWOOD, OSB OR WATERBOARD SHEATHING
A FOR STUD SPECIFICATION
ED AT TOP & BOTTOM WITH 3/ 3-1/4" (82mm) TOE NAILS
LATE FASTENED TOGETHER WITH 3" (76mm) AT
O.C. 23

DOUBLE TOP TLATES INC. TO TAKE STATE TO THE STATE THE S

24 EXPOSED FLOOR:

TE# 28 //VAPOUR BARRIER IN CONFORMANCE W / O.B.C.- 9,25,3, & 9,25,4,

SUNKEN FINISHED AREAS: 240

DOUBLE MASONRY WYTHE WALL: (25)

(250) CORBEL MASONRY VENEER:

(26) SILL PLATE:

FLOOR ASSEMBLIES:

OLIS @ 7-10" (2400mm) O.C. FASTENED TO SHALL BE EMBEDDED NOT LESS THAN 4"

OR PLACED ON A LAYER NOT LESS THAN 1" APRESSING, OR FOAM GASKET, OR PLACED

mmX 64mm) NAILED TO U/S OF JOISTS @ MAX. 6-11" (2100mm) O.C. TO SILL OR HEADER @ ENDS

im) OR 2" x 2" (381

nmX 64mm) OR 2" X 2" (38mmX 38mm) CRO mm) O.C. 28 S IRRAPPING ED TOGETHER OR m) SOLID BLOCKING ® MAX, 6"11" (2100mm

(28)

9.23.14.3, 9.23.14.4 n) WAFERBOARD (R-I GRADE) OR EQUIVALENT IS AS PER FLOOR PLANS

29 PORCH SLAB:

(8)

DO ON PLAN)
JUARD AS PER #360
MARY MINIMUM 2% TO ROOF SCUPPER
SAREY MINIMUM 2% TO ROOF SCUPPER
SBmm x 38mm) CROSS PURLINS @ 16" (400mm) O.C. FOR

rch.) 1835 546) Insulation Between Joists 4Tinuous air/vapour Barrier In Conformance W/ O.B.C. 9.25.3. s richt. ADD 1/2' (12.7mm) GYPSUM BOARD W/ PAINIED CEILING OR ADD 5/8' (15.9mm) GYPSUM BOARD W/ TEXTURED CEILING (0.B.C.-1.9.29.5.3.)

(%)

nm x 38mm), CROSS PURLINS ® 16" (400mm), O.C., FOR VER JOISTS (OBC 9.19.1.2, VENTING NOT LESS THAN 1/150 OF

8.9.25.4. -ADD 1/2" (12.7mm) GYPSUM BOARD W/ PAINTED CEILING OR -ADD 5/8" (15.9mm) GYPSUM BOARD W/ TEXTURED CEILING (O.B.C..1.9.29.5.3.)

I, JORGE MORENO DECLARE THATI HAVE REVIEWED AND TAKEN DESIGN RESPONSIBILITY FOR THE DESIGN WORK ON BEHALF OF RN DESIGN LID, UNDER DIVISION C, PART-3 SUBSECTION-3.2.4 OF THE BUILDING CODE. I AM QUALIFIED AND THE FIRM IS REGISTERED IN THE APPROPRIATE CLASSES / CATEGORIES.

Tice River Homes

Legacy

ES JM ES

ROOF ASSEMBLIES (31) IYPICAL ROOF:

acing as per truss manufacturer Ough on prefinished fascia and vented soffit (vinyl or

- ATTIC VENTILATION 1:300 OF INSULATED CEILING AREA WITH, 50% AT SOFFIT.

-CONTINUOUS AIR/VAPOUR BARRIER IN CONFORMANCE W/ O.B.C. 9.25.3.

-3.1 Arriter 3.1 RIV CAS L. 9.7.26.7.2.
-3.1 Arriter STRIP OUT FEQUIED AS PER CO.B.C. 9.2.6.7.2.(3)
-3.46° (10mm) PLYWOOD SHEATHING OR COS 0(0.2. GRADE) WITH "H" CLIPS.
-2.36° (10mm x 184mm) @ 16° O.C. W / 2'x2° (38mm x 38mm) CROSS
-2'x6° (38mm x 184mm) @ 16° O.C. W / 2'x2° (38mm x 38mm) CROSS
PURINIS @ 24° O.C. MAX. SPAN 17-0° (5180mm)
-2'x10° (38mm x 355mm) @ 16° O.C. W / 2'x2° (38mm x 38mm) CROSS
PURINIS @ 24° O.C. MAX. SPAN 17-0° (5180mm)
-4-R31 [RSIS, LA44] INSULATION
-AMIN. 3° CLEARANCE FROM U/S OF ROOF SHEATHING TO INSULATION
-CONTINUOUS ARRIFER IN CONFORMANCE WITH

(33) CONVENTIONAL FRAMING:

O.B.C. TABLE A6 OR A7 -2" X 6" (38mm X 140mm) RAFIERS @ 16" (400mm) O.C. MAX. SPAN 12-9" (3890mm) mm X 89mm) COLLAR TIES AT MIDSPANS LOISIST TO BE 2" X 6" (38mmX 140mm) @ 16" (400mm) O.C. THERWISE NOTED. LLEY RAFIERS TO BE MIN. 2" (50mm) LARGER THAN COMM.

-0" O.C.,
FOR FLOOR
JECT INTO CAMTY (34) ATTIC ACCESS HATCH:
OBC 9.19.2.1. 8, 58-12.3.1.18.(1)
-19.3/4" X 27 1/2" (500mm X 700mm) ATTIC HATCH WITH
WEATHERSTRIPPING 8, BACKED W/ R20 (RSI 3.52) INSULATION

O.B.C., 9.8.4.

-MAX. RISE

-MIN. RUN

-MIN. RUN

-MIN. RUN

-MIN. MED

-9-1/4" (230mm)

-MAX. NOSING

-9-1/4" (235mm)

-MAX. NOSING

-9-1/4" (235mm)

-MIN. WD1H

-2-10" (860mm)

(BETWEEN WALL FACE)

-MIN. WD1H

-2-10" (800mm)

(RETWEEN WALL FACE)

-MIN. WD1H

-2-11" (900mm)

-MIN. RUN

-MOCLED TREADS:

-MIN. RUN

-MIN. AVG. RUN

-7 7/8" (200mm)

-HINSHED RALING ON WOOD PICKTIS MAX. 4" BETWEEN PICKTIS

-EXTERIOR CONC. SIEPS TO HAVE MIN. 9 1/4" (235mm) TREAD &

MAX. 77/8" (200mm) RISE

-FOUND. WALL REQUIRED WALLEN WALL. GENERAL:
(35) PRIVATE STAIRS:
O.B.C. 9.8.4.

ALL REQUIRED WHEN NUMBER OF RISERS EXCEEDS 2 :OUND. WALL TO BE MIN. 4"-0" (1220mm) BELOW GRADE

FELLING UNITS
NAIDRAILS ARE TO BE CONTINUOUS EXCEPT WHERE INTERRUPTED BY DOOR
NYS, LANDINGS OR POSTS AT CHANGES IN DIRECTION

HEIGHT:

O. B.C. 9.8.7.4

- 2-10" (865mm) MIN. TO 3-2" (965mm) MAX.

- 3-6" (1070mm) WHERE GUARDS ARE REQUIRED ON LANDINGS)

- - MEASURED VERIICALLY FROM THE TOP OF THE HANDRAIL TO A
STRAIGHT LINE DRAWN FROM THE TANGENT TO THE TREAD NOSING

PROJECTIONS:
O.B.C., 9.8.7.6
- HANDRALLS AND PROJECTIONS BELOW HANDRALLS INCLUDING STEP STRINGERS TO PROJECT A MAXIMUM OF 4" (100mm) INTO THE REQUIRE WIDTH OF THE STAIR

TERMINATION:
O.B.C. 9.8.7.3
- ONE HAND RAIL SHALL EXTEND HORIZONTALLY NOT LESS THAN 11.3/4".
(300mm) BEYOND THE TOP & BOTTOM OF EACH STAIR

FINISH:

O.B.C., 9.8.9.6

-IREADADS ARE TO BE WEAR AND SLIP RESISTANT, SMOOTH, EVEN AND FREE FROM DEFECTS PER OBC 9.8.9.6.(4)

- STAIRS AND RAMPS SHALL HAVE A COLOUR CONTRAST OR DISTINCTIVE VISUAL PATTERN TO DEMARCATE THE LEADING EDGE OF THE TREADS.

LANDING AND THE BEGINNING AND END OF A RAMP.

(38)

INTERIOR GUARDS:

O.B.C., SB-7 & 9.8.8.3.
-GLARDS 1O BE 3-6" (1070mm) HIGH
-FOR DWELLING UNITS GUARDS TO BE A MIN. OF 2"-11" (900mm) HIGH
-FOR DWELLING UNITS GUARDS TO BE A MIN. OF 2"-11" (900mm) HIGH
-FOR DWELLING UNITS GUARDS TARRS, RAMPS AND LANDINGS
-PICKETS TO HAVE 4" (100mm) MAX. SPACING
-GUARDS FOR FLIGHTS OF STEPS (EXCEPT EXIT STAIRS) TO BE 2"-11" (900)

Oldorinini)
MELLING UNITS GUARDS TO BE A MIN. OF 2'-11" (900mm) HIGH
MELLING UNITS GUARDS TO BE A MIN. OF 2'-11" (900mm) HIGH
MELLING UNITS GUARDS TO BE 3'-6" (1000mm) HIGH WHERE WALKINC
BE MORE THAN 5'-11" (1800mm) ABOVE ADJACENT GRADE.
S TO HAVE 4" (100mm) MAX. SPACING
DE MID-SPAN POSITS AS PER SB-7.
DS FOR FLICHTS OF STEPS (EXCEPT EXIT STAIRS) TO BE 2'-11" (900mm) I

(36b) EXTERIOR GUARDS ® JULIET BALCONY:

KIMUM OF 6-0". ING W/76mm VERTICAL OPENING TO UDIX A-9.8.8.5. LING UNITS GUARDS TO BE 2-11" (900mm) WHERE FLC FERENCE IS LESS THAN 5'-11" (1800mm) AS PER O.B.C.

-PROVIDE SAME ANCHOR BOLTS @ 36" O.C. FOR BASE PLATE CONNEC (37) -LINEN CLOSET 4 SHELVES MIN. 1'-2" (350mm) DEEP -WASHROOMS TO BE MECHANICALLY VENTED TO PROVIDE AT LEAST (38) -CAPPED DRYER VENT

| 42| -2 RISERS MAXIMUM PERMITTED TO BE LAID ON GROUND | SMOKE ALARM, O.B.C.- 9.10.19. | -PROVIDE 1 ON EACH FLOOR INCLUDING BASEMENTS

UCLUDING BASEMENTS

IN CIRCUIT AND INTERCONNECTED SO ALL RANY ONE OF THEM SOUNDS AND HAVE A ERVICING BEDR

-ALRENATE POWER SOURCE. THAT CAN POWER ALARM FOR 7 DAYS, FOLLOWED BY 4 MINUTES OF ALAR SON MONOXIDE ALARM (CMA), O.B.C.-9.33.4.
REE THERE IS A FULL BURNING APPLANCE A CMA SHALL BE PR
ACENT TO EACH SLEEPING AREA.
A TO BE WIRED IN CIRCUIT TO SOUND SMOKE ALARMS WHEN (45) CARBO

-main door to be operable from inside w/out key -provide a viewer with a viewing angle of not less than 160 Unless glazing is provided in door or a sidelight is present. -ra (RSI 0.70) where a storm door is not provided 46 -M.

(47) -Garage man doors to be gas proofed with self closer. Weatherstripping, threshold & dead bolt per 0.B.C. 9.10.13.15.-R4 (RS10.70)

48) -IRavel from a floor level to an exit or egress door limited to one floor except;

1) where that floor level has access to a balcony one floor level has access to a balcony.



D ENCINEERING

SD-02

17052

49 EXTERIOR COLUMN W/ MASONRY PIER:

POST ANCHORED TO PORCH SLAB NCRETE CAP, REFER TO HEIGHT. SABOLE.
SARION OF POST CLAD W/ DECOR. SURROUND PER ELEVATION

490

Dmm X 140mm) WOOD POST CLAD W/ DECOR. SURRO N DRAWINGS) ANCHORED TO PORCH SLAB W/ RATIVE STRUCTURAL COLUMNS MAY REPLACE 6" X 6", 14" THEY ARE IN ACCORDANCE WITH O.B.C. 9.17.4. EXTERIOR COLUMN:

(50)

COVIDE THE FOLLOWING: SCREEN SCREEN

(51

7-37.2.3. 2-3.2.3.4. ARE TO BE REINFORCED TO PERMIT THE FUTURE INSTALLATION FS AS PER O.B.C. 3.8.3.8.(3)(a)&(c) & 3.8.3.13.(2)(f) &

(4)(C) (ARS TO BE INSTALLED AS PER O.B.C. 9.8.7.7.(2)

WINDOW GUARDS: (53)

<u> 5S & RAMPS</u> - OBC 9.8.8.1.(8) (900mm) OR GREATER DOES NOT REQU

nm) ABOVE FLOORS WHERE ADJACENT GRADE 1) REQUIRE A GUARD PER OBC 9.8.8.2.

WINDOW TO BE NON PER OBC 9.8.8.1.(8)(b

TO BE NO.1 AND NO. 2 SPF UNLESS NOTED

JÜBLE SIÜLD, GF CHEMINGS,
JÜBLE HEADER JÜGISTS AROUND FLOOR OPENINGS WHEN THEY /
IWEEN 3-11" (1200mm) AND 10-6" (3200mm)
JÜBLE FRIMMER JÖRISTS WHEN HEADER JÖISTLENGTH IS BETWEEN 2:7"
""" (2000mm) 2000mm) SOLID BLOCKING UNDER NON-LOAD BEARING

D FLOOR JOISTS
Y BE A MAX, 24" (600mm) FROM LOADBEARING WALLS
S, ARE PERPENDICULAR TO FLOOR JOISTS
MARTAL HANGERS TO BE USED FOR JOISTS AND BEAMS WHEN
INTO SIDES OF BEAMS, TRIMMERS AND HEADERS
STS SUPPORTING ROOF LOADS SHALL NOT BE CANTILEVERED
THE ALM!" (ARDITMEN) BEYOND SUPPORTS FOR 2" X 8" (38mm) X UNDER LOADBEARING WALLS WHEN WALLS

ORTING ROOF LOADS SHALL NOT BE CANTILEVERED (600mm) BEYOND SUPPORTS FOR 2" x 10" (38mm x


WATERPROOF WALLS IN BATHROOMS: -REQUIRED AS PER OBC 9.29.2.1.

to be sealed to the air 8, vapor barrier That separate Heated space from unheated space shall Verall coefficient of heat transfer of

GLAZED WITH LOW-E COATING SHALL HAVE AN OVERALL COEFFICIENT OF HEAT TRANSFER OF

1) TO (6) REQUISED IN ALL DWELLING UNITS TO RECEIVE DRAIN WATER HOWERS OF FROM AT LEAST 2 SHOWERS WHERE THERE ARE 2 HOWERS PROVIDED THERE IS A CRAWL SPACE OR STOREY AS PER OBC SB-12.3.1.1.1.(22) & 3.1.1.12.

NEITHER THE GRANTING OF A PERMIT NOR THE APPROVAL OF SPECS & DRAWINGS NOR INSPECTIONS MADE BY THE OFFICIAL HAVING JURISDICTION SHALL RELIEVE THE OWNER FROM REQUIREMENTS OF THE ONTARIO BUILDING CODE AND ANY OTHER REFERENCED REQUIREMENTS

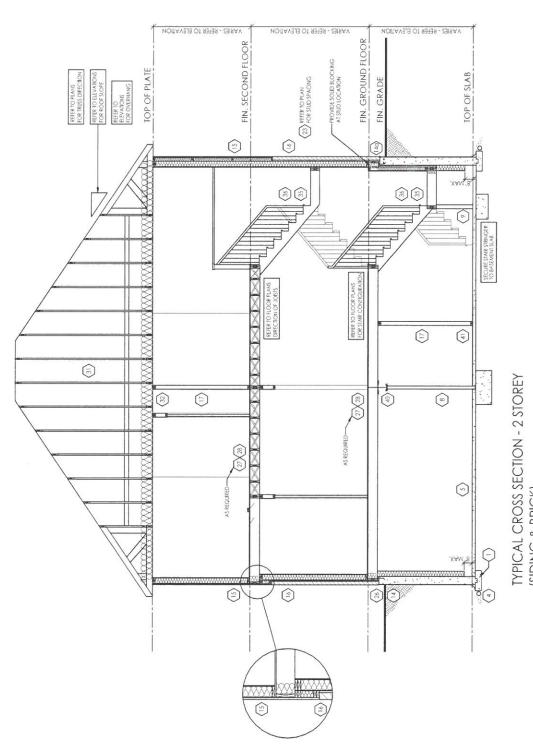


TYPICAL CROSS SECTION - 2 STOREY (SIDING & BRICK)
N.T.S.

THESE DRAWINGS ARE NOT TO BE SCALED. ALL DIMENSIONS MUST BE VERIFIED BY CONTRACTOR PRIOR TO COMMENCEMENT OF ANY WORK ANY DISCREPANCIES MUST BE REPORTED DIRECTLY TO RN DESIGN LTD

SOLID BEARING TO BE SAME WIDTH AS SUPPORTED MEMBER!

(F)

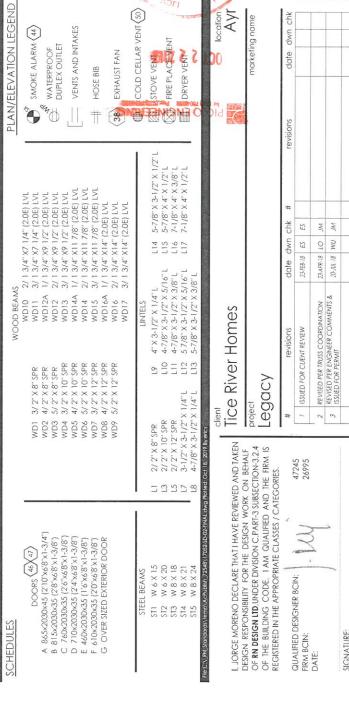

17052

SD-02 scale 3/16" = 1'0"

MN DESIGN

-D-EQ